
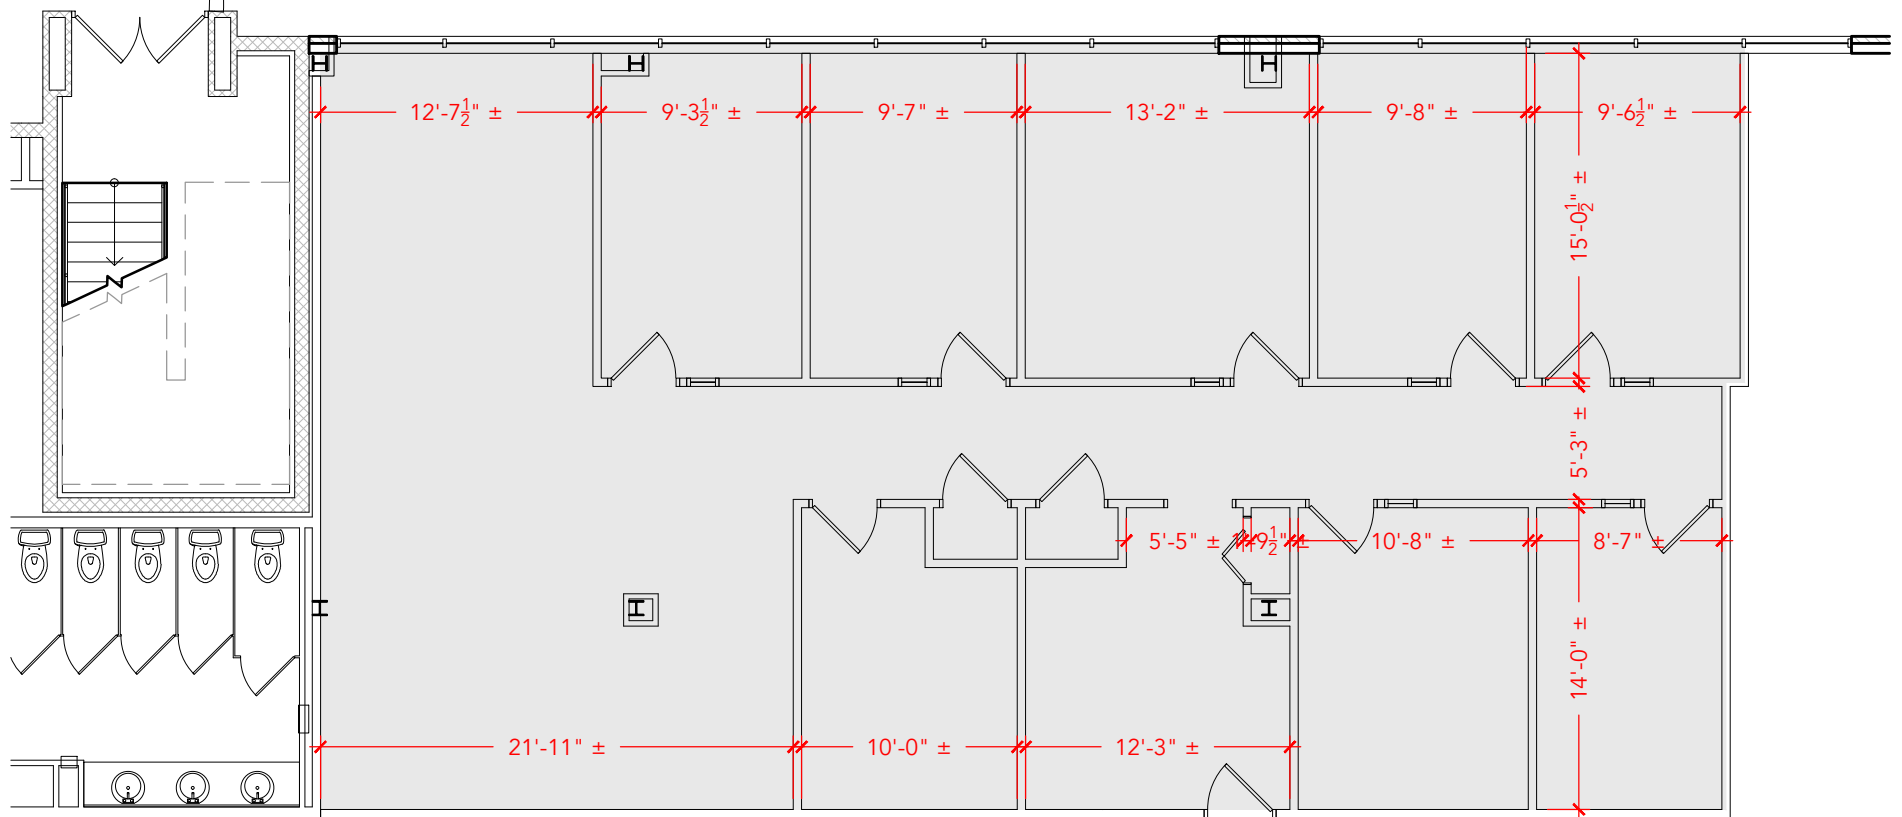


TOTAL SF AVAILABLE - 2,602 RSF(12%)

[Click to access 3D model](#)

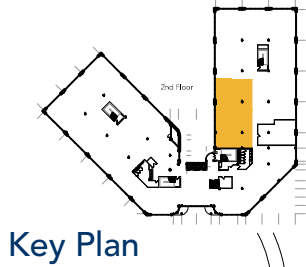

## Floor Plan