


Key Plan

TOTAL SF AVAILABLE - 2,451 RSF (12%)

[Click to access CADD file](#)

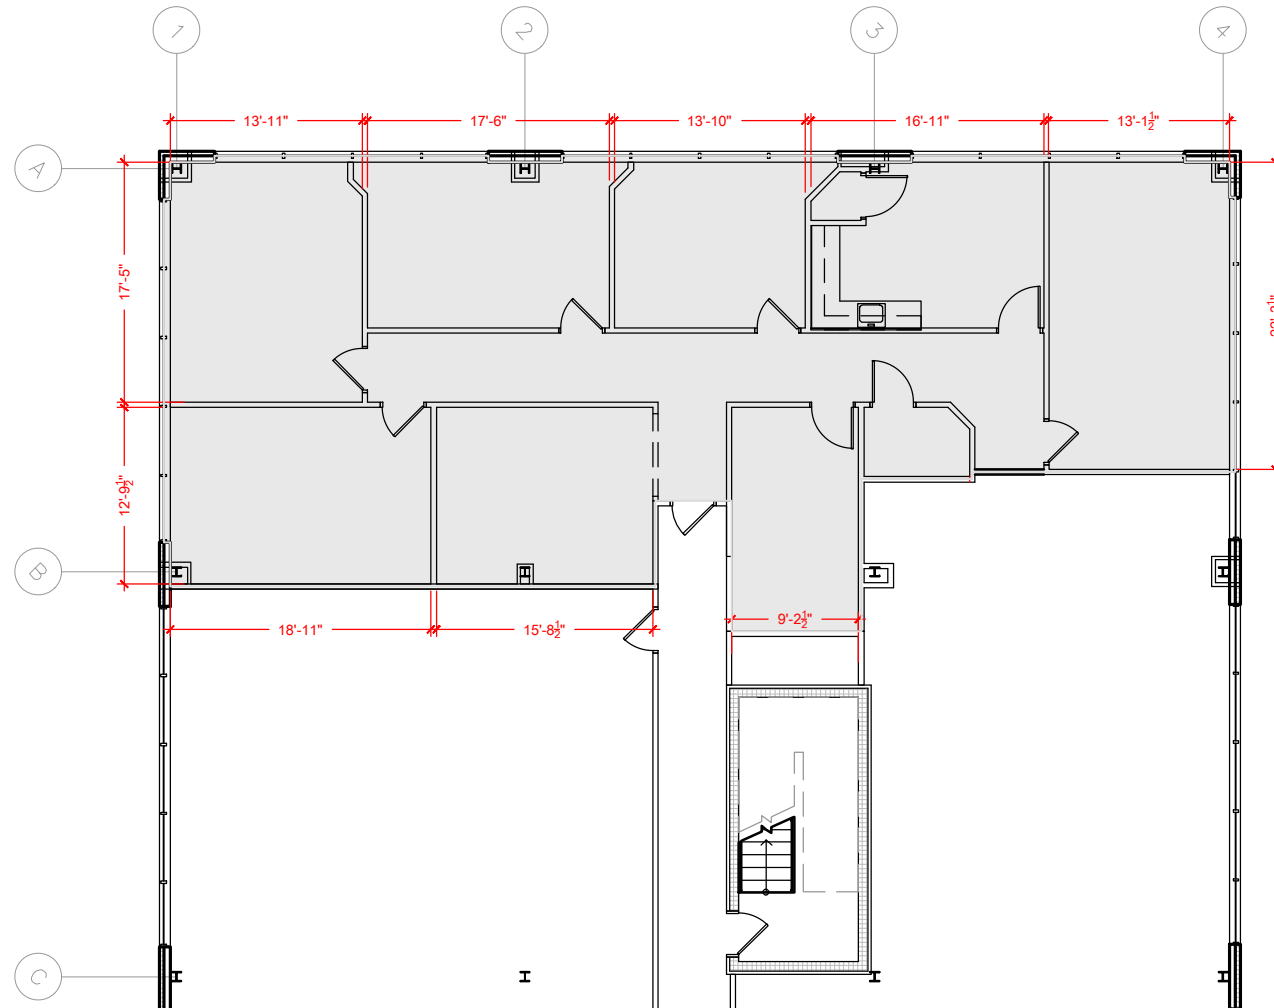

Floor Plan