



TOTAL SF AVAILABLE -2,449 RSF (12%)

[Click to access CADD file](#)

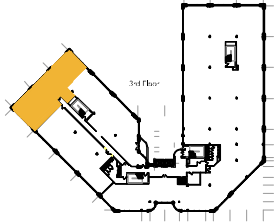

Key Plan

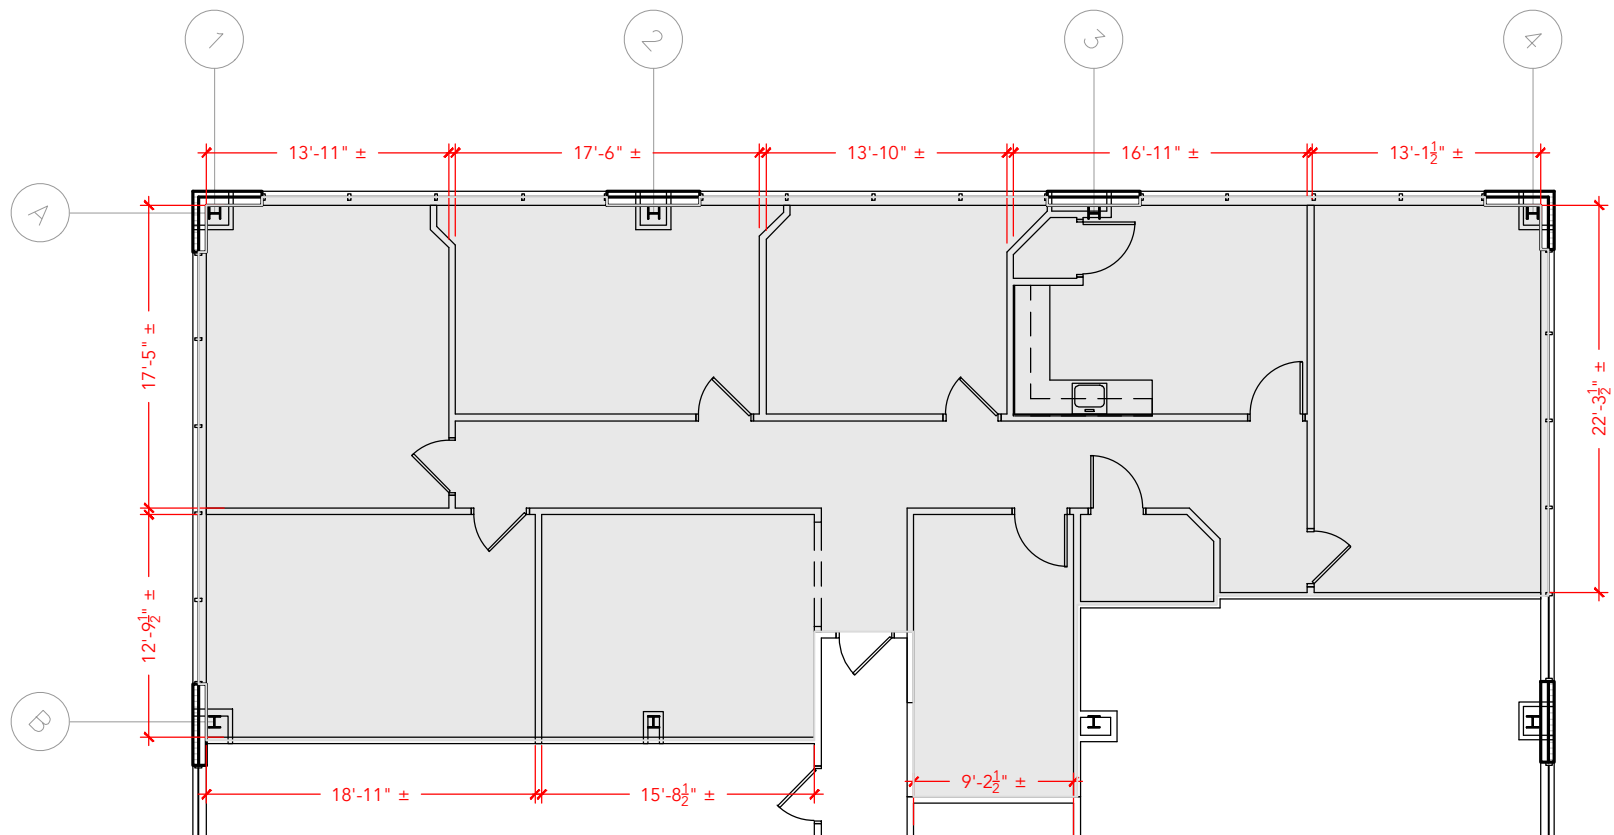

## Floor Plan