
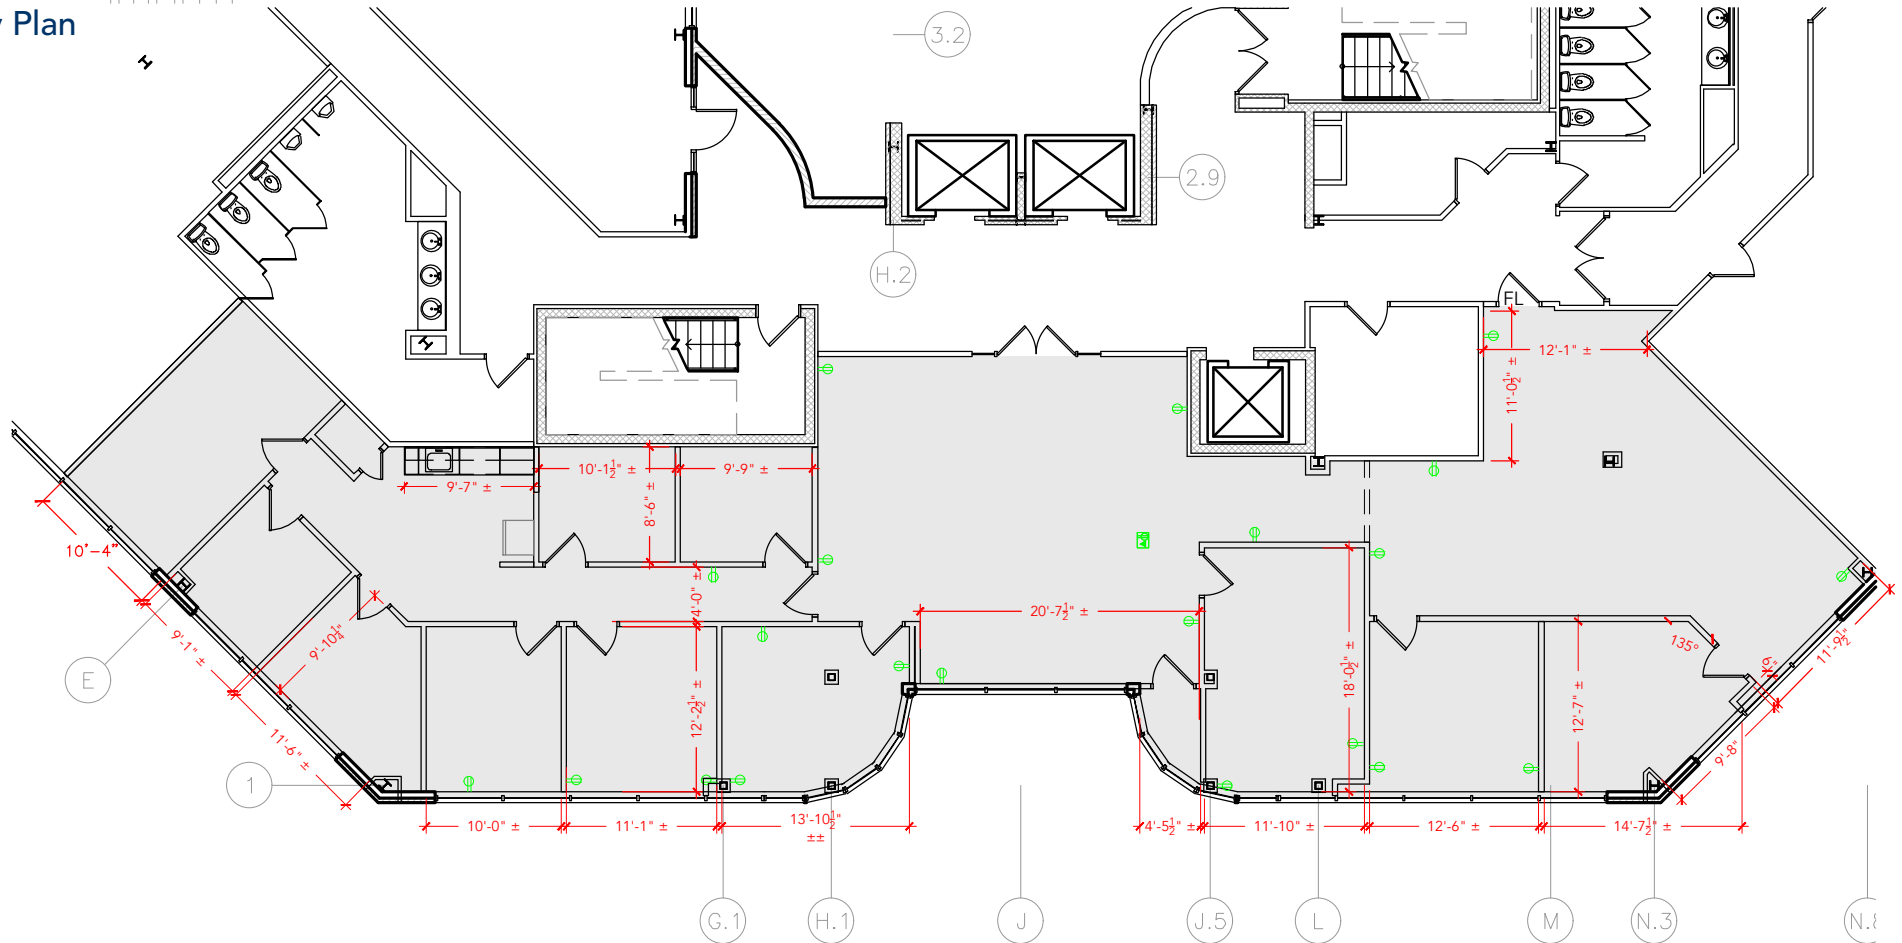


TOTAL SF AVAILABLE -3,686 RSF (12%)

[Click to access CADD file](#)

Key Plan

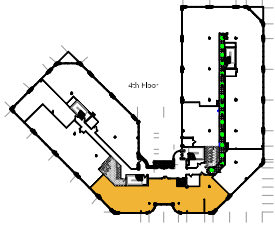

Floor Plan