


100 WEST ROAD

100 WEST ROAD TOWSON, MD 21204 SUITE 406

TOTAL SF AVAILABLE -1,419 RSF (12%)

Click to access3D model



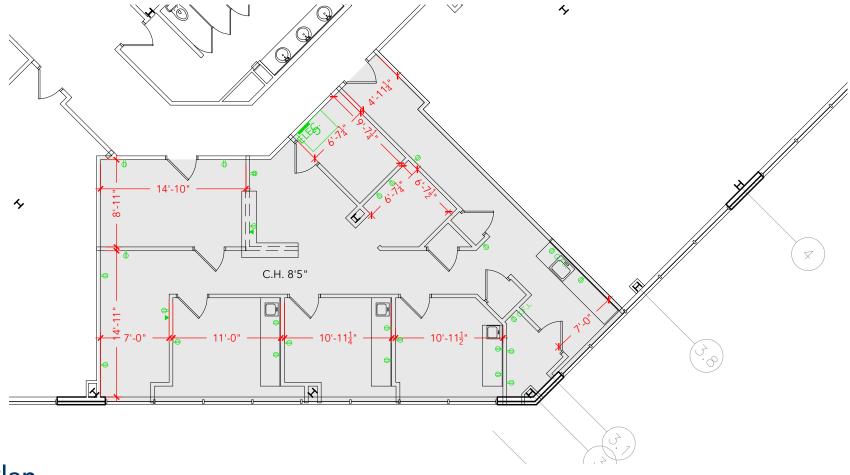

Floor Plan