
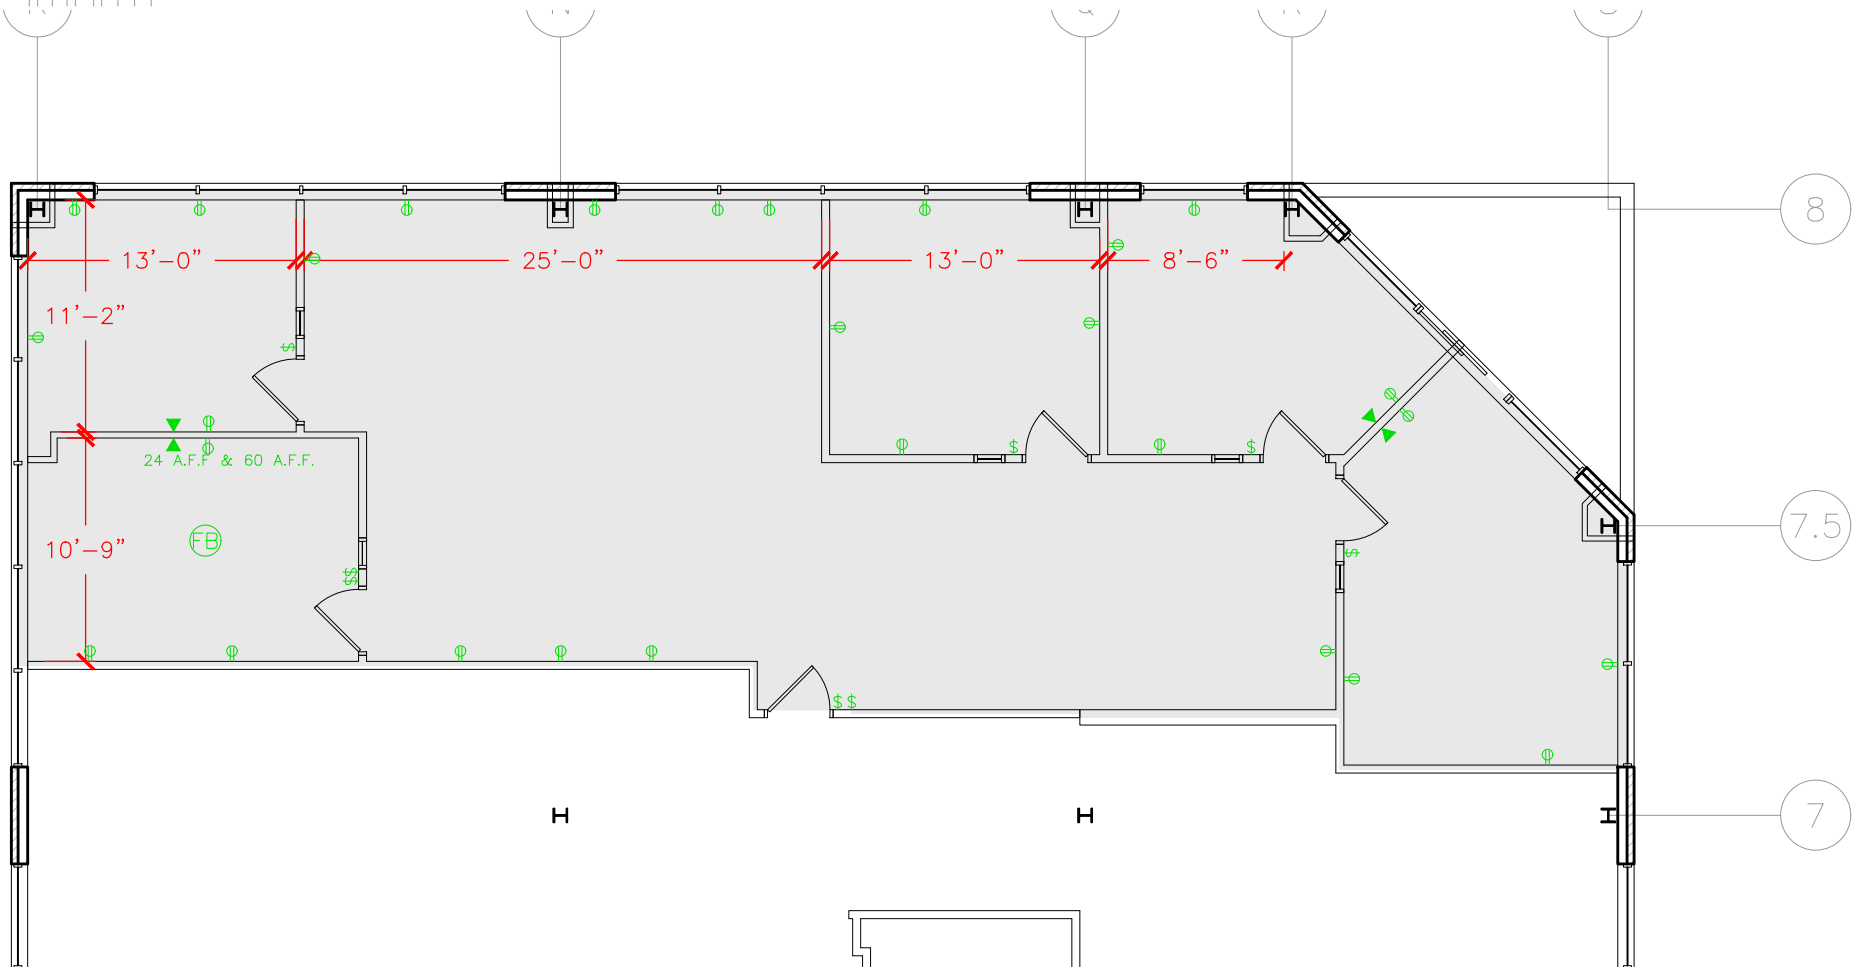


TOTAL SF AVAILABLE - 2,174 RSF (12%)

[Click to access 3D model](#)

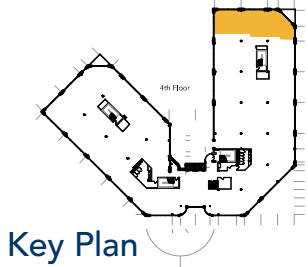

## Floor Plan