


TOTAL SF AVAILABLE - 3,000 SF


OFFICE - 1,093 SF

WAREHOUSE SF - 1,907 SF

[Click to access 3D model](#)

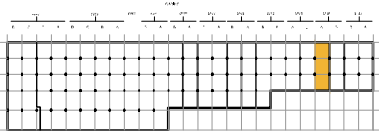

Key Plan

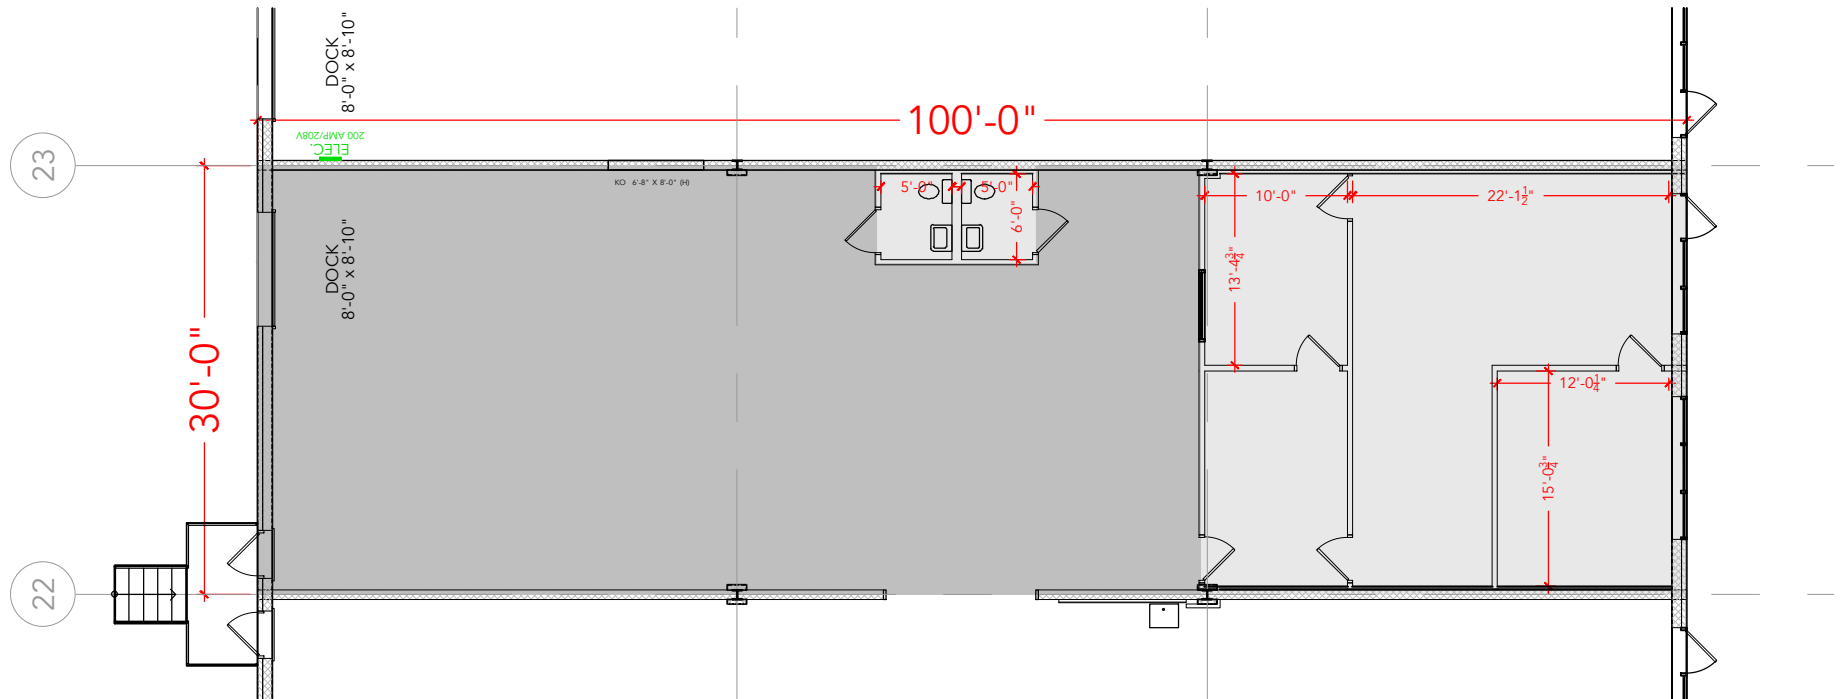

Floor Plan