



TOTAL SF AVAILABLE - 3,000 SF

OFFICE - 1,015 SF
WAREHOUSE - 1,985 SF

[Click to access 3D model](#)

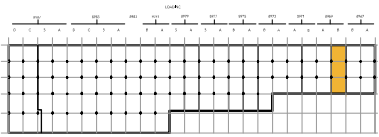

Key Plan

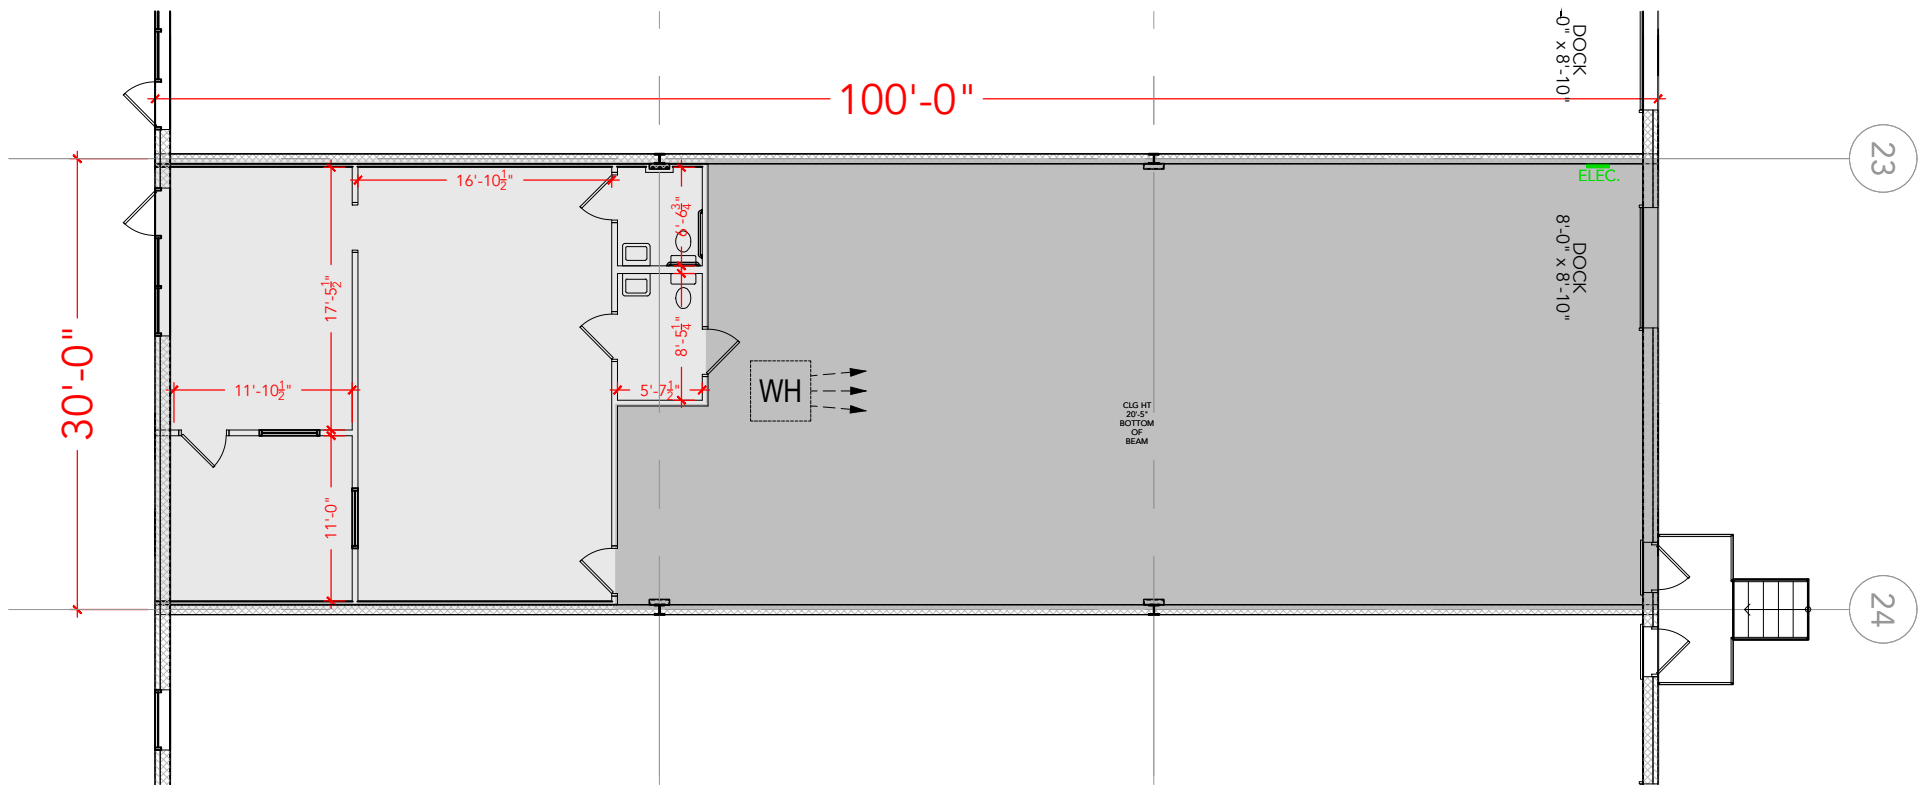

Floor Plan