


TOTAL SF AVAILABLE - 4,050 SF


OFFICE - 655 SF

WAREHOUSE - 3,395 SF

[Click to access 3D model](#)

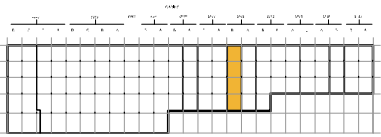

Key Plan

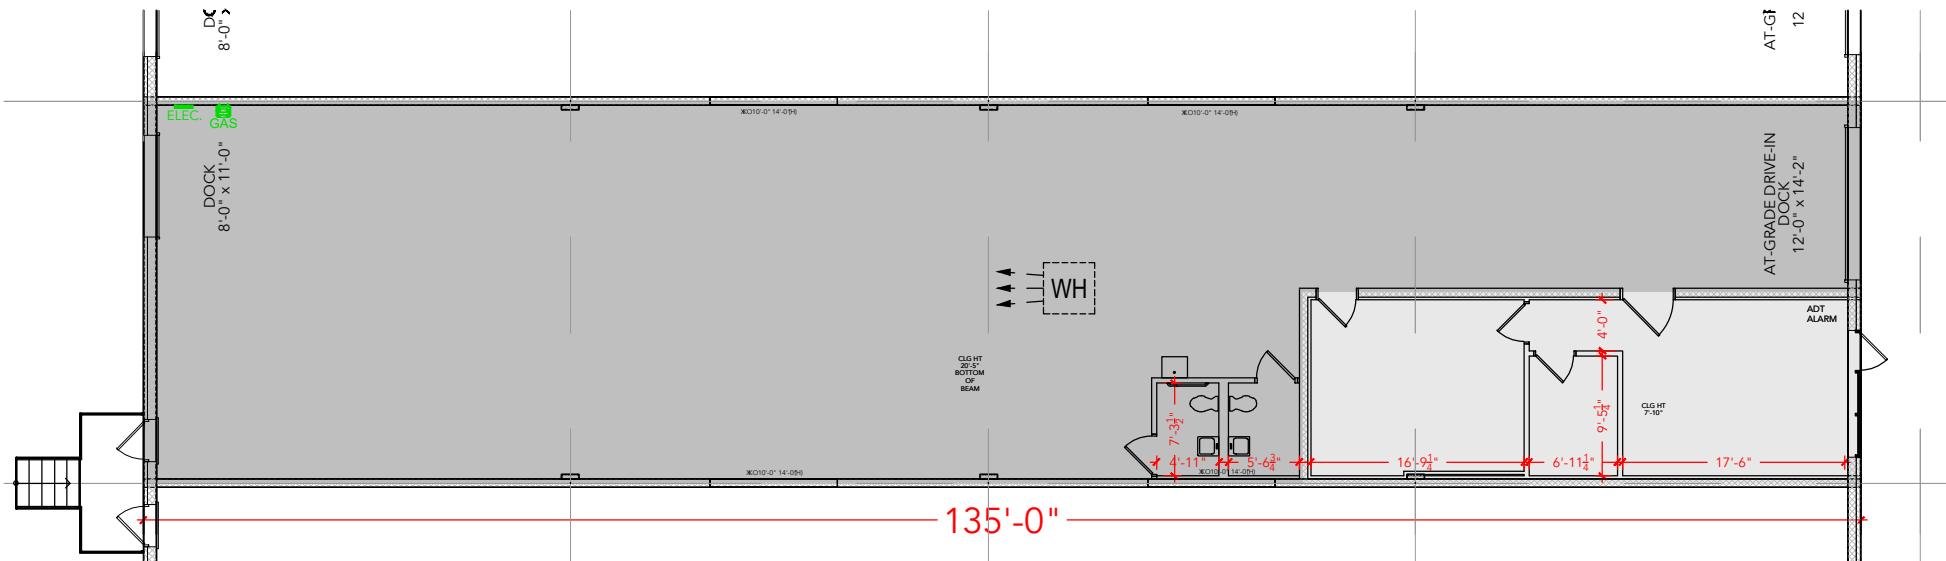

Floor Plan