


TOTAL SF AVAILABLE - 8,100 SF

OFFICE - 1,373 SF


WAREHOUSE SF - 6,727 SF

*1,156 SQFT MEZZ. NOT INCLUDED IN TOTAL

[Click to access 3D model](#)

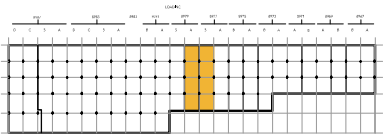

Key Plan

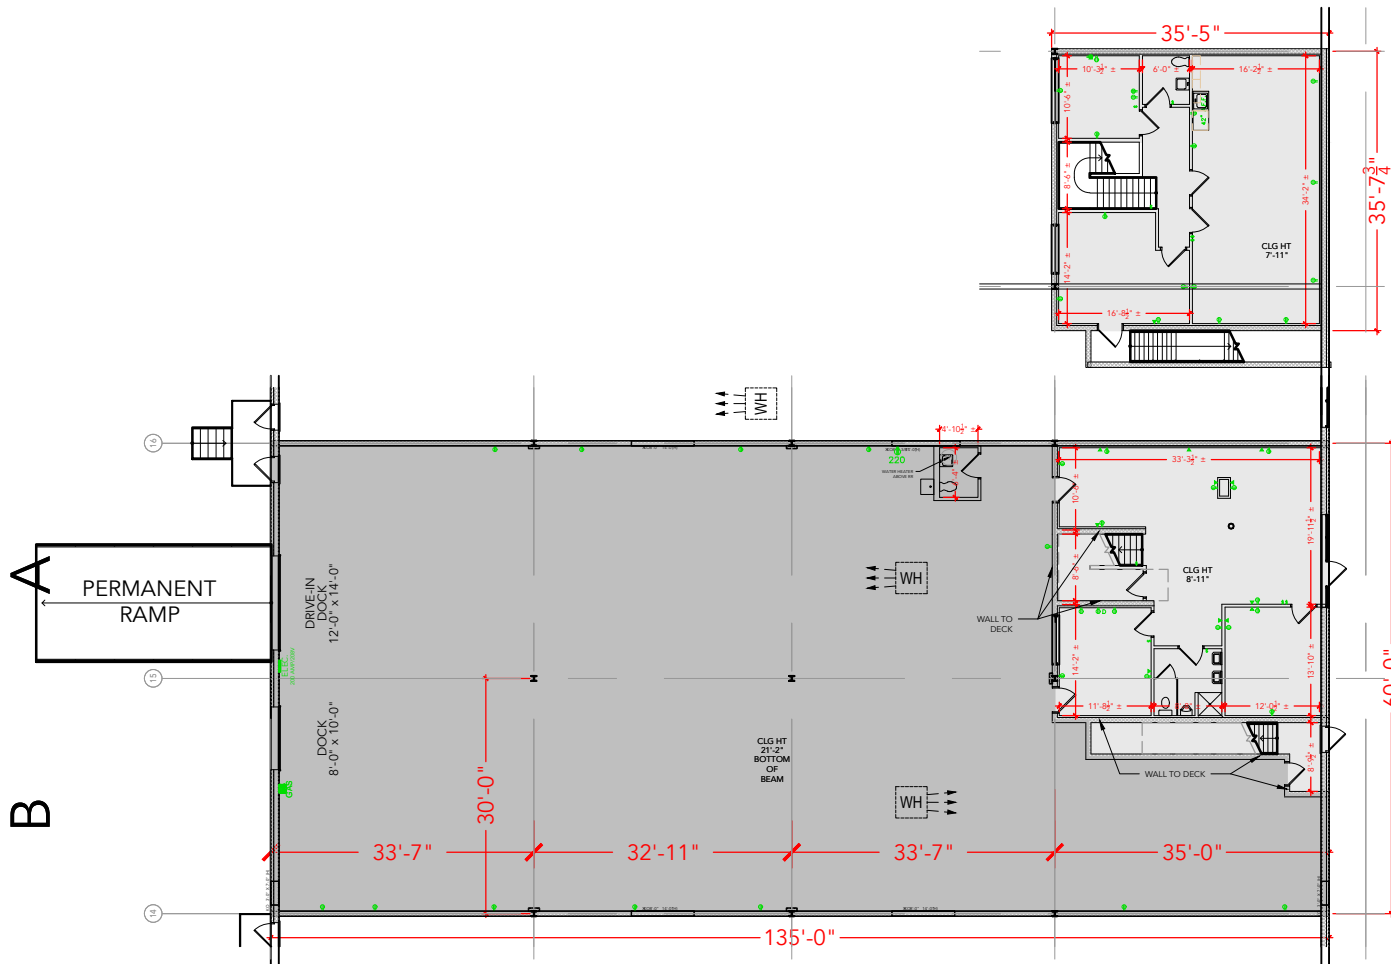

Floor Plan