


Key Plan

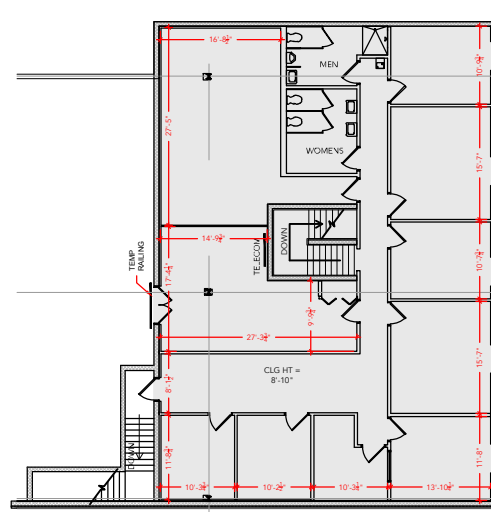

TOTAL SF AVAILABLE - 11,146 SF

OFFICE - 3,361 SF


WAREHOUSE - 7,785 SF

* 3,222 SF MEZZ NOT INCLUDED IN TOTAL SF

[Click to access 3D model](#)

C

D

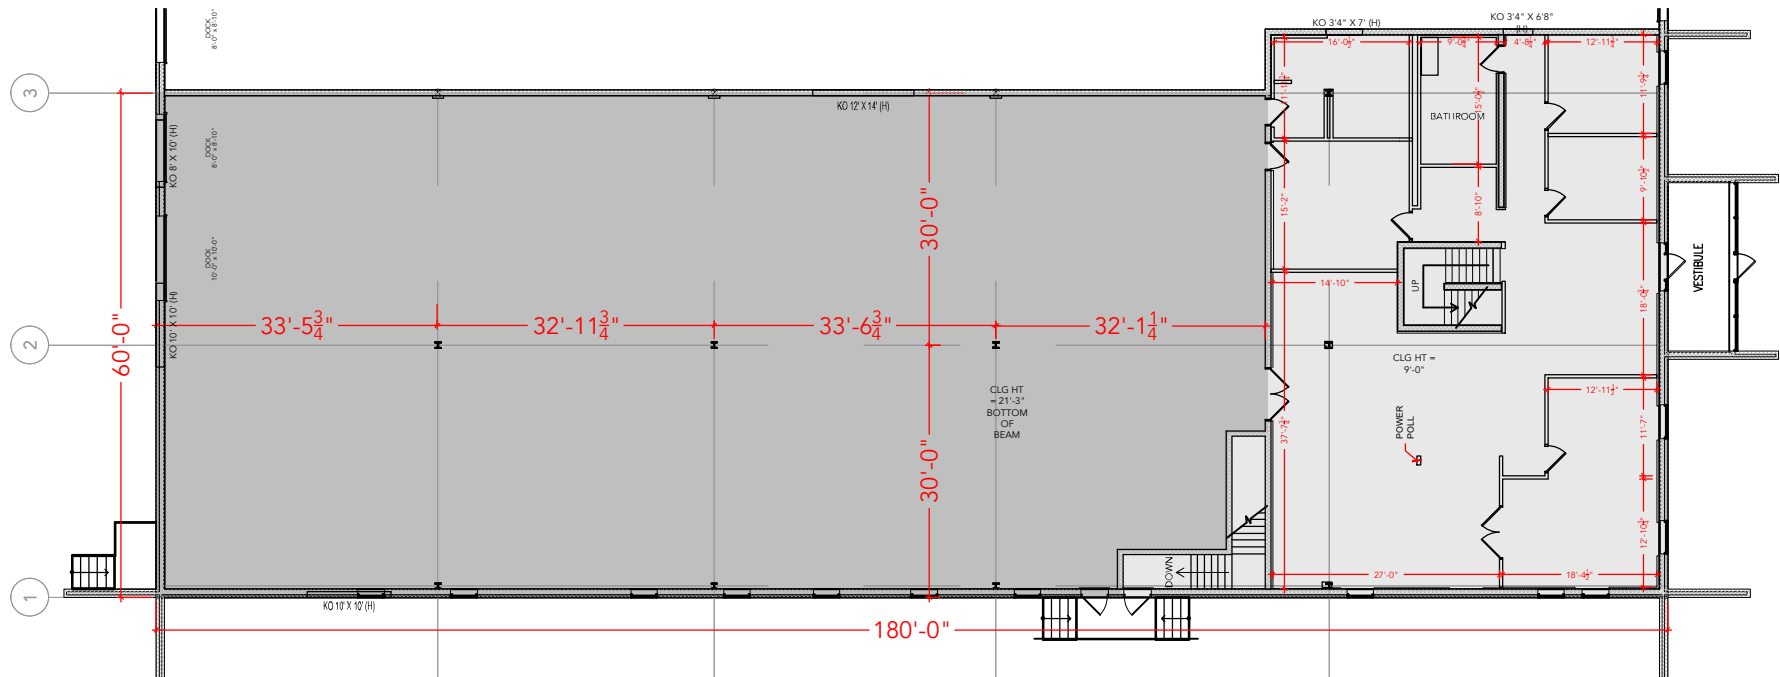

Floor Plan