


TOTAL SF AVAILABLE - 12,000 SF

OFFICE - 837 SF

WAREHOUSE - 11,163 SF

[Click to access 3D model](#)

Key Plan

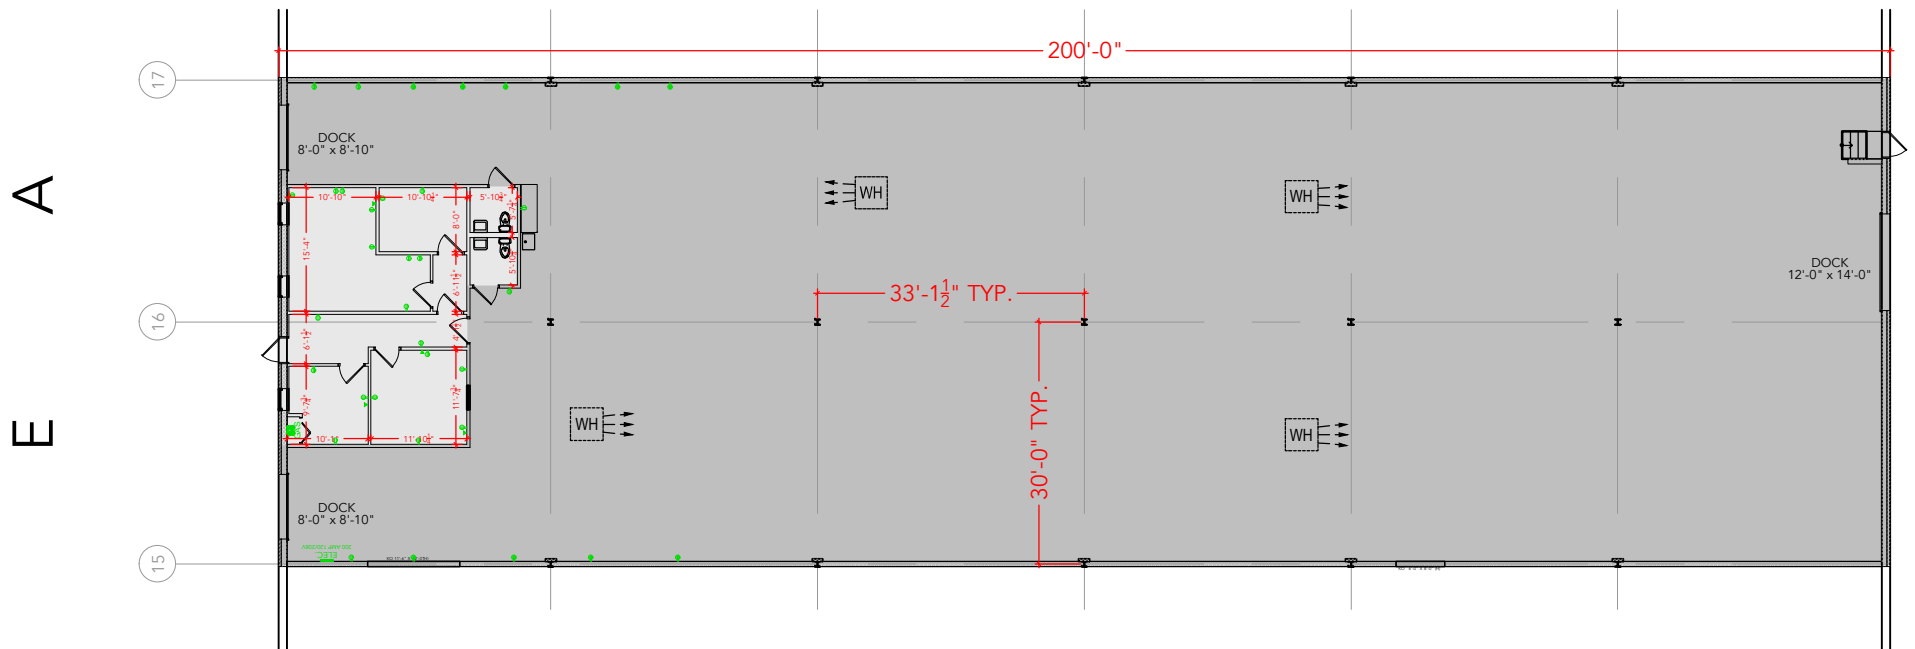

Floor Plan