


TOTAL SF AVAILABLE -12,000 SF


OFFICE - 1,222 SF

WAREHOUSE - 10,778 SF

[Click to access CADD file](#)

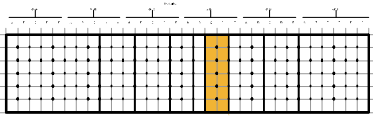

Key Plan

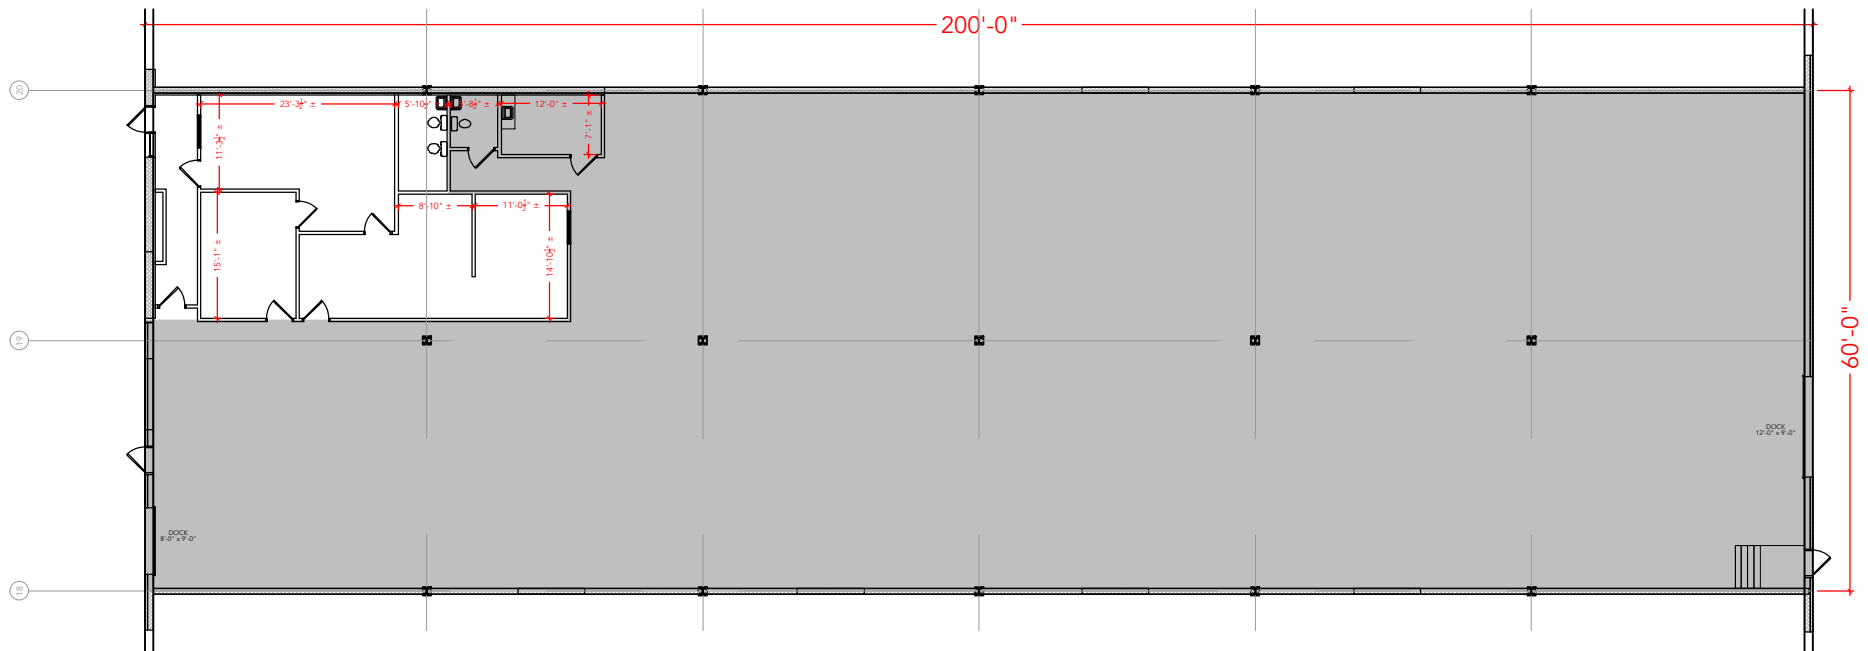

Floor Plan