


TOTAL SF AVAILABLE -12,000 SF


OFFICE - 1,635 SF

WAREHOUSE - 10,365 SF

[Click to access CADD file](#)

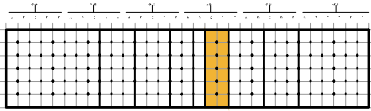

Key Plan

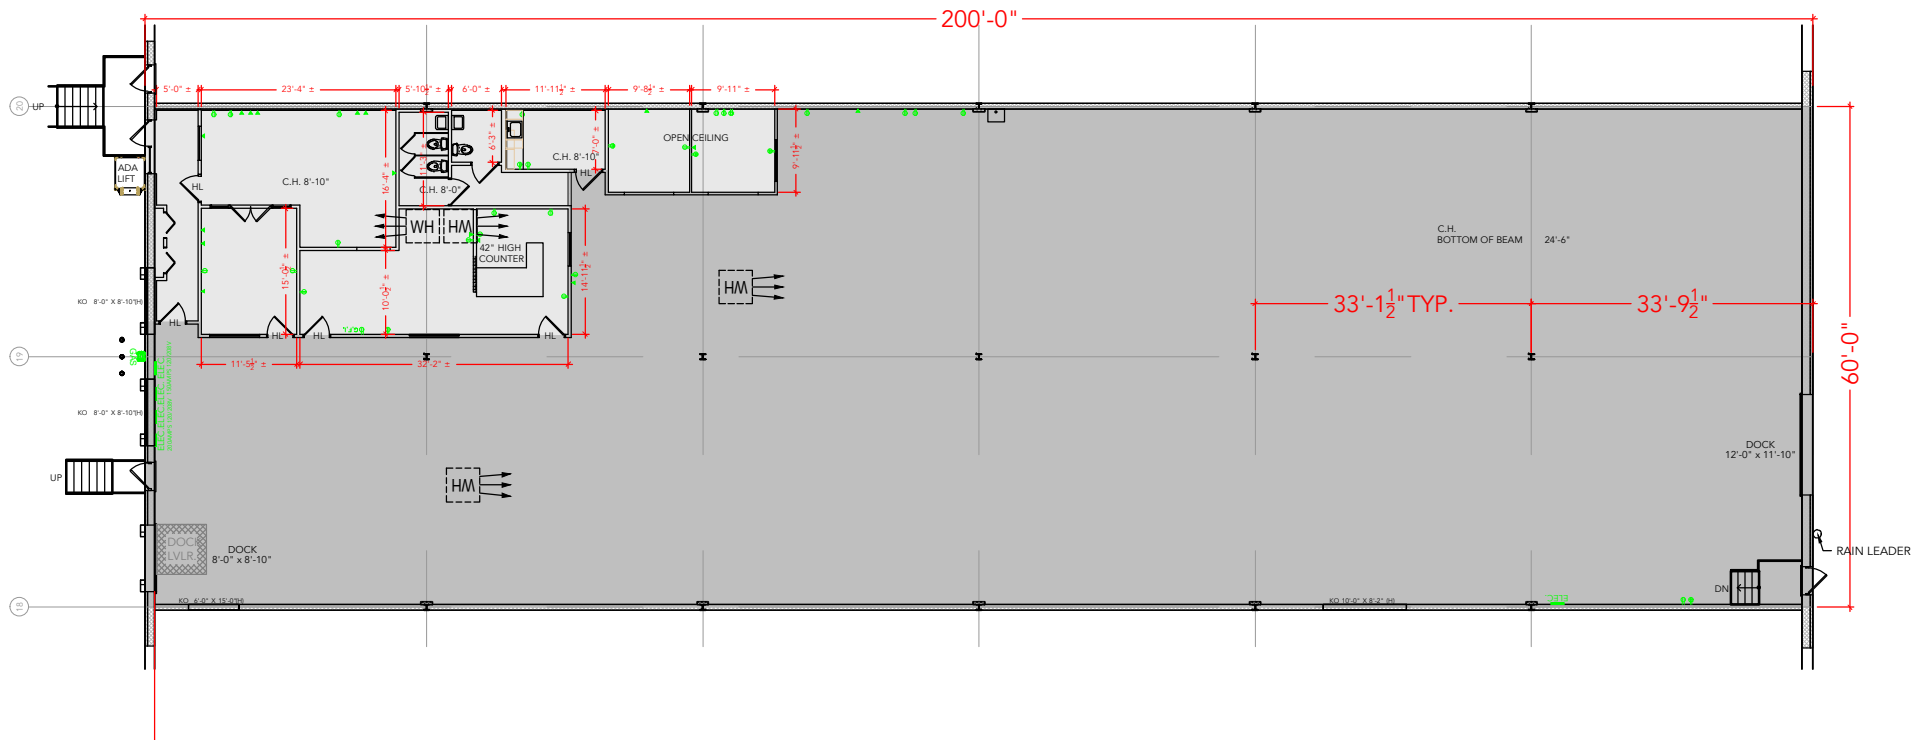

Floor Plan