


COLUMBIA CORPORATE PARK

8850 STANFORD BLVD. COLUMBIA, MD 21045 SUITE 1750

TOTAL SF AVAILABLE - 1,991 RSF (12%)



Key Plan

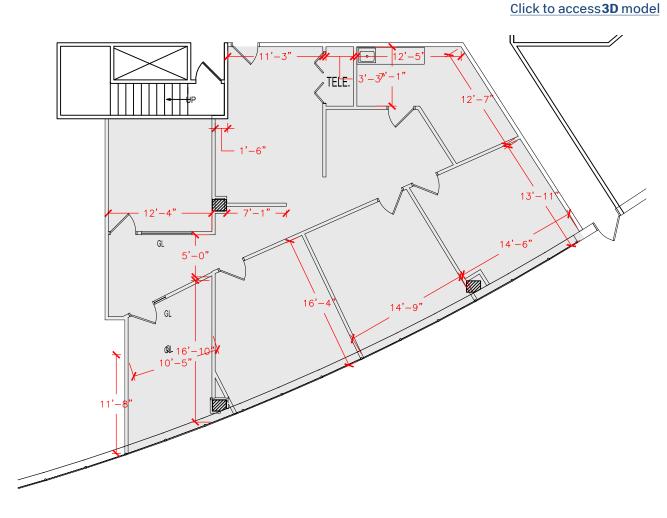

Floor Plan