



TOTAL SF AVAILABLE - 3,453 RSF(12%)

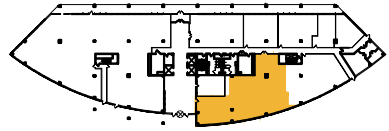

[Click to access 3D model](#)

Key Plan

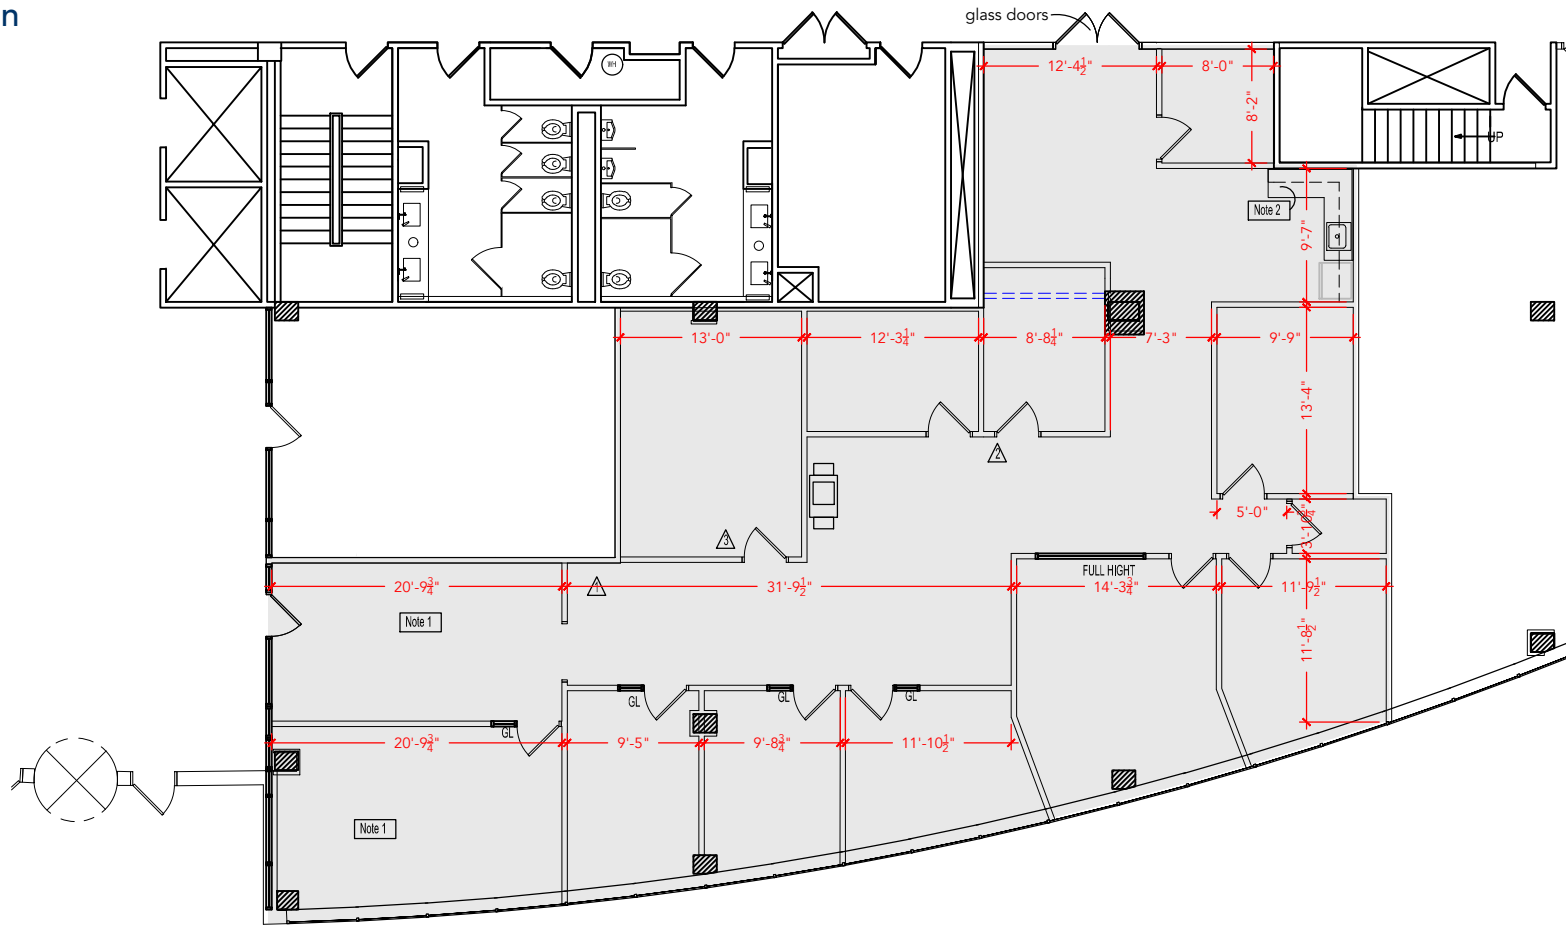

Floor Plan