



TOTAL SF AVAILABLE - 3,104 RSF (16%)

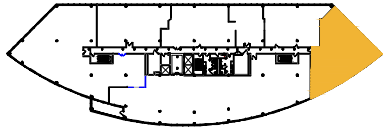

Key Plan

[Click to access CADD file](#)

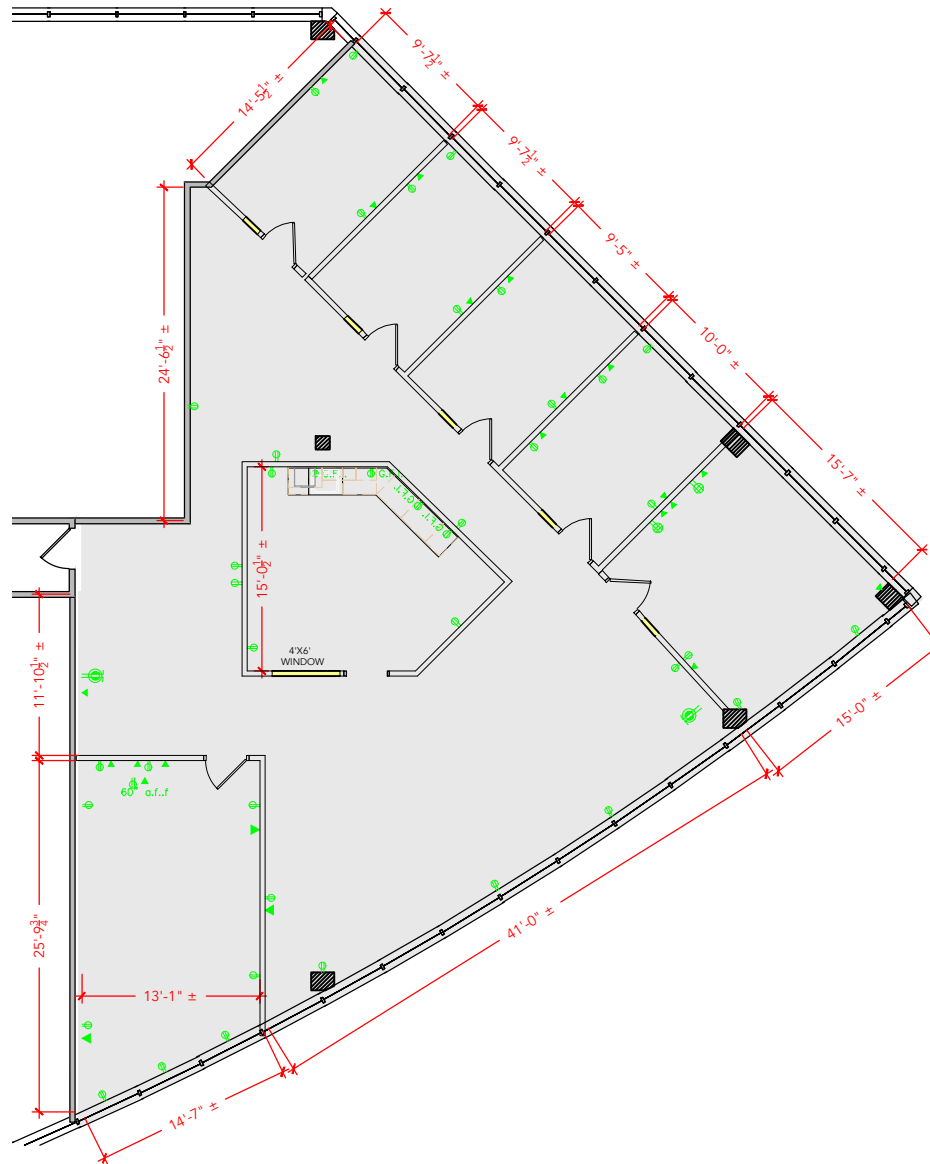

Floor Plan