



TOTAL SF AVAILABLE -2,979 RSF (12%)

[Click to access 3D model](#)

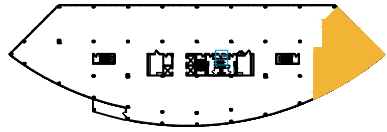

Key Plan

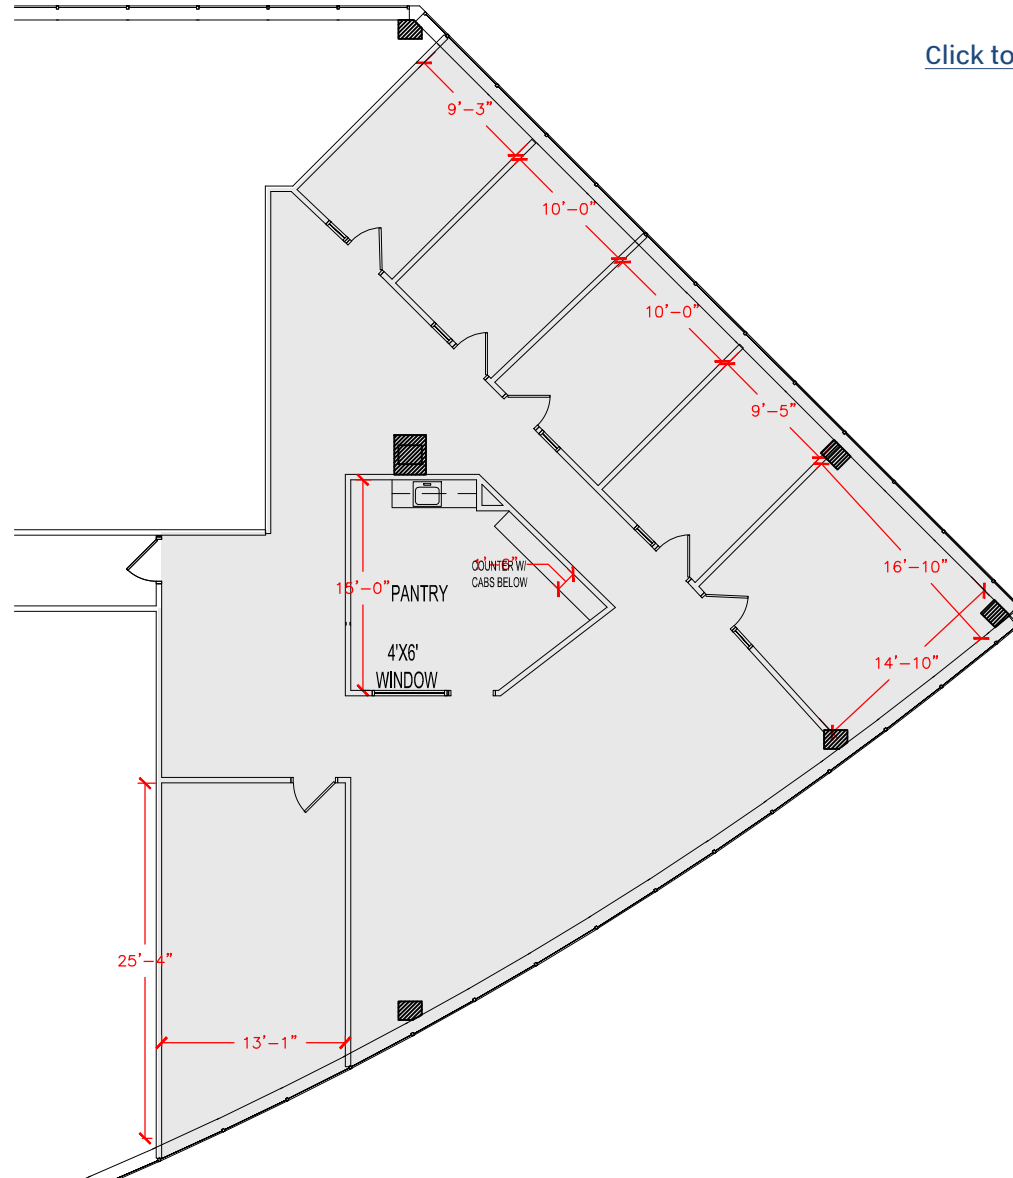

Floor Plan