
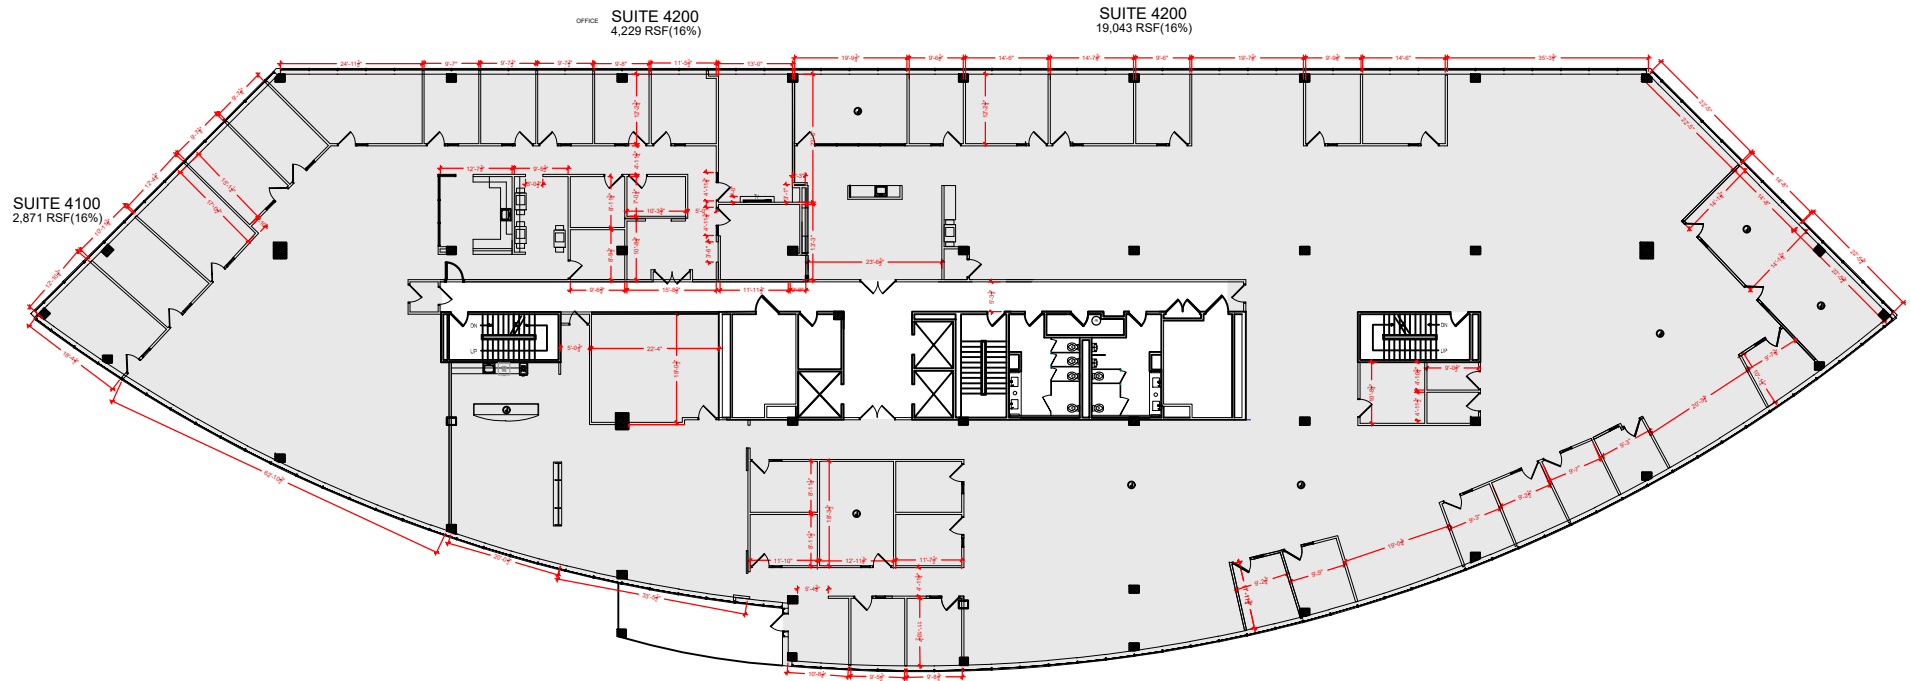


TOTAL SF AVAILABLE - 26,143 RSF (16%)

[Click to access 3D model](#)

Key Plan

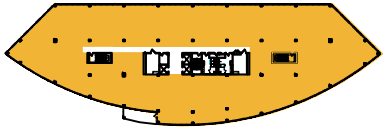

Floor Plan