



TOTAL SF AVAILABLE - 2,100 SF

OFFICE - 1,300 SF
WAREHOUSE SF - 800 SF

[Click to access 3D model](#)

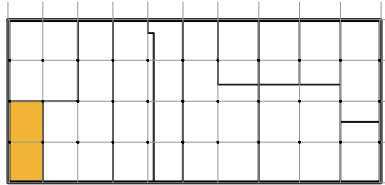

Key Plan

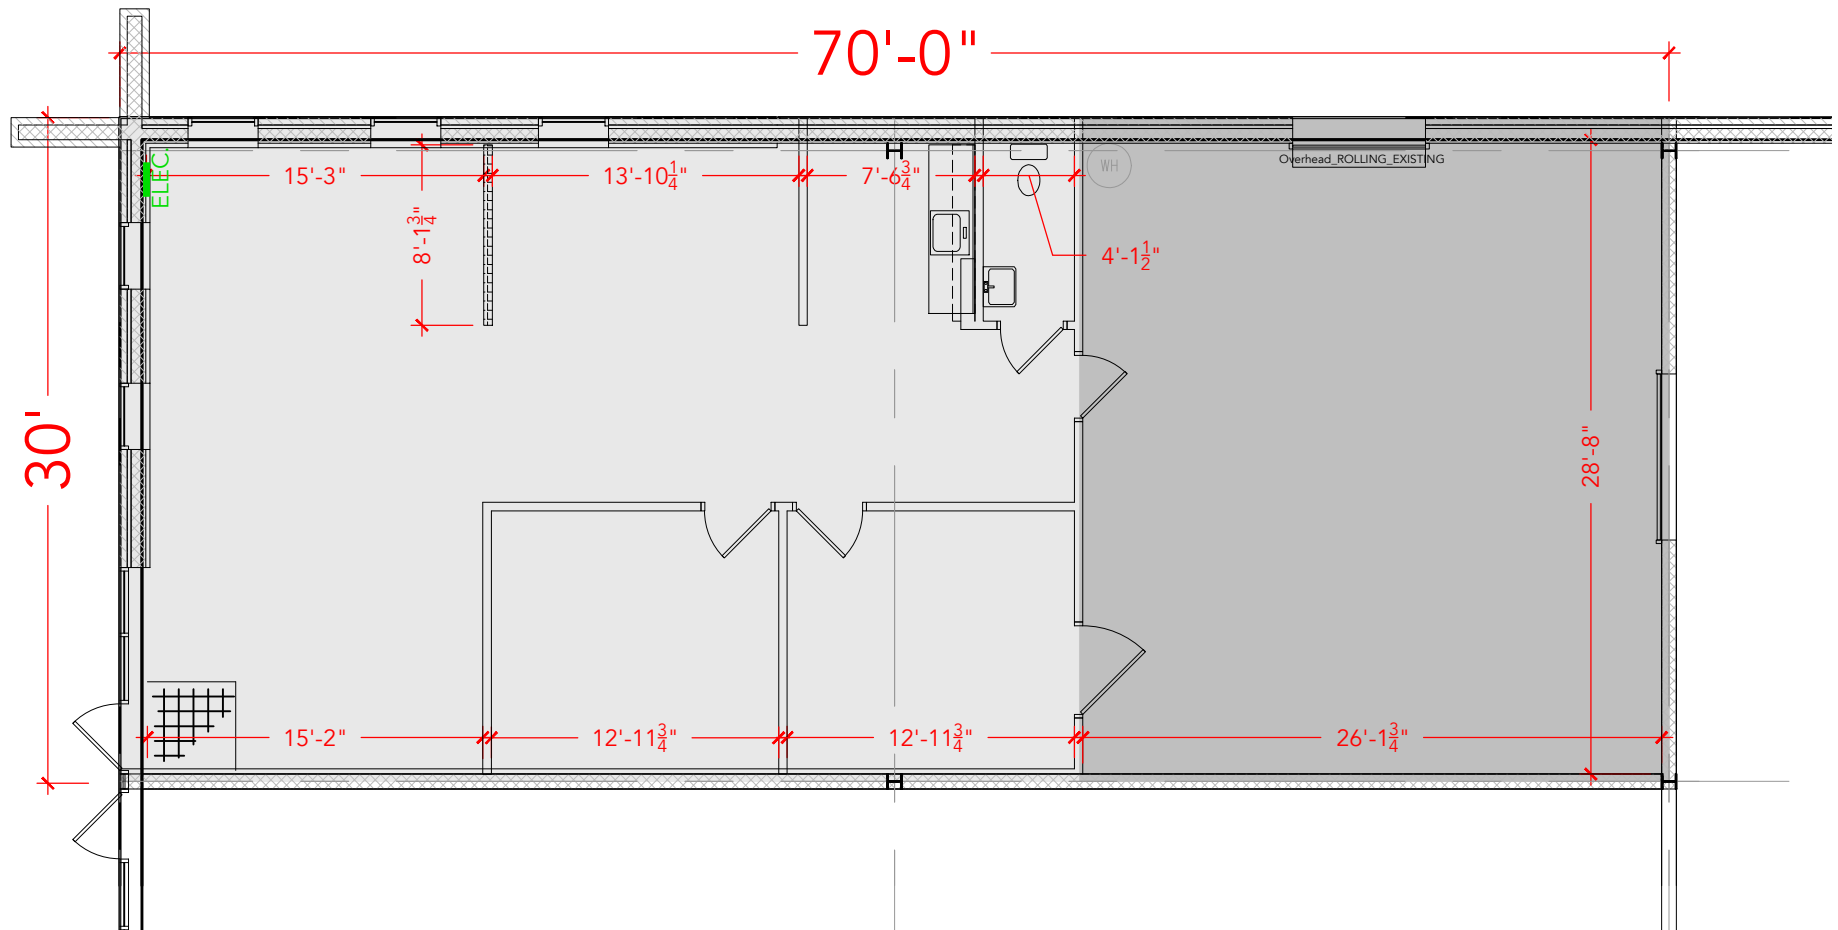

Floor Plan