



## **HUNTRIDGE BUSINESS PARK**

12117 INSURANCE WAY, HAGERSTOWN, MD 21740 SUITE D

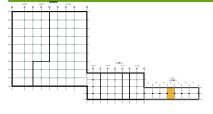

**Key Plan** 

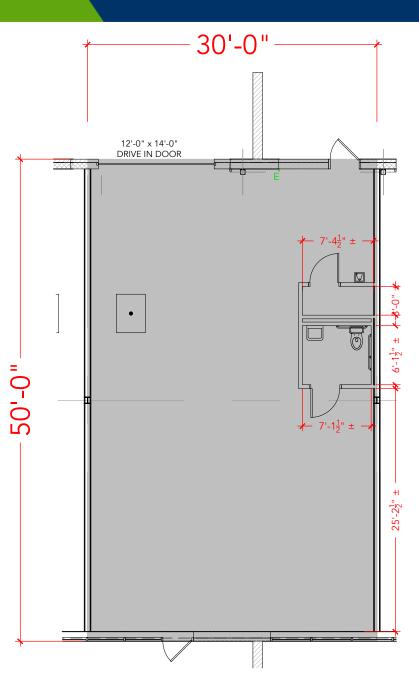

TOTAL SF AVAILABLE - 1,500 SF

OFFICE - 0,000 SF WAREHOUSE - 1,500 SF

Click to access3D model

Floor Plan