



TOTAL SF AVAILABLE -1,850 RSF (12%)

[Click to access CADD file](#)

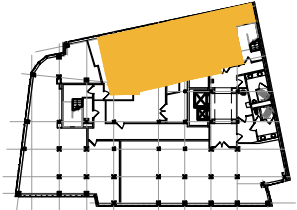

Key Plan

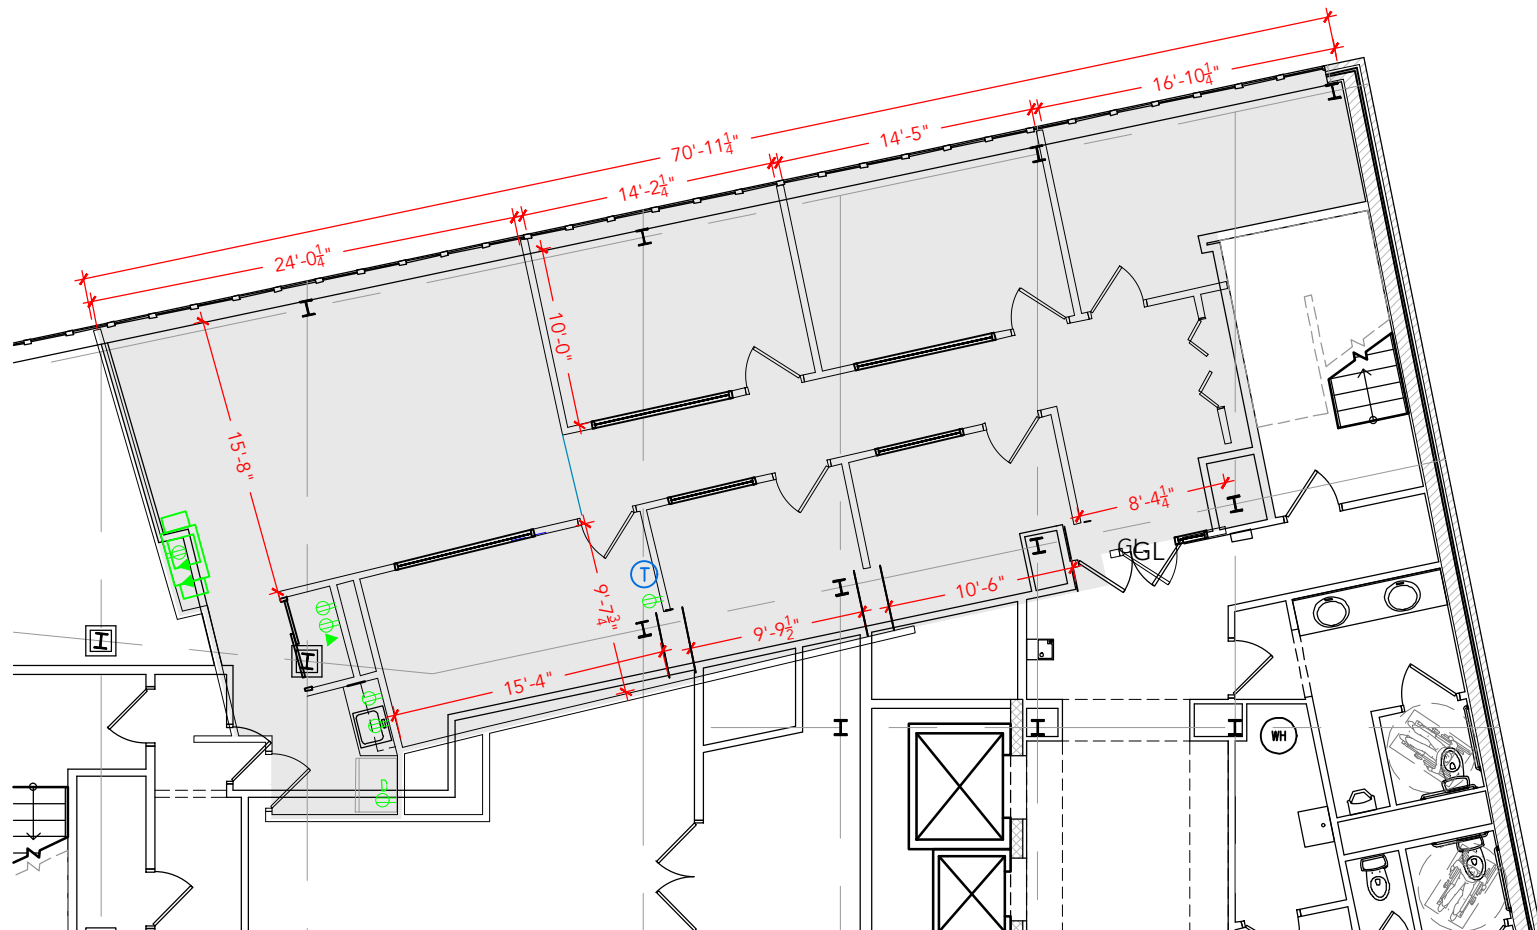

Floor Plan