



TOTAL SF AVAILABLE - 1,665 RSF (12%)

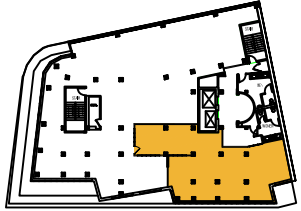

Key Plan

[Click to access CADD file](#)

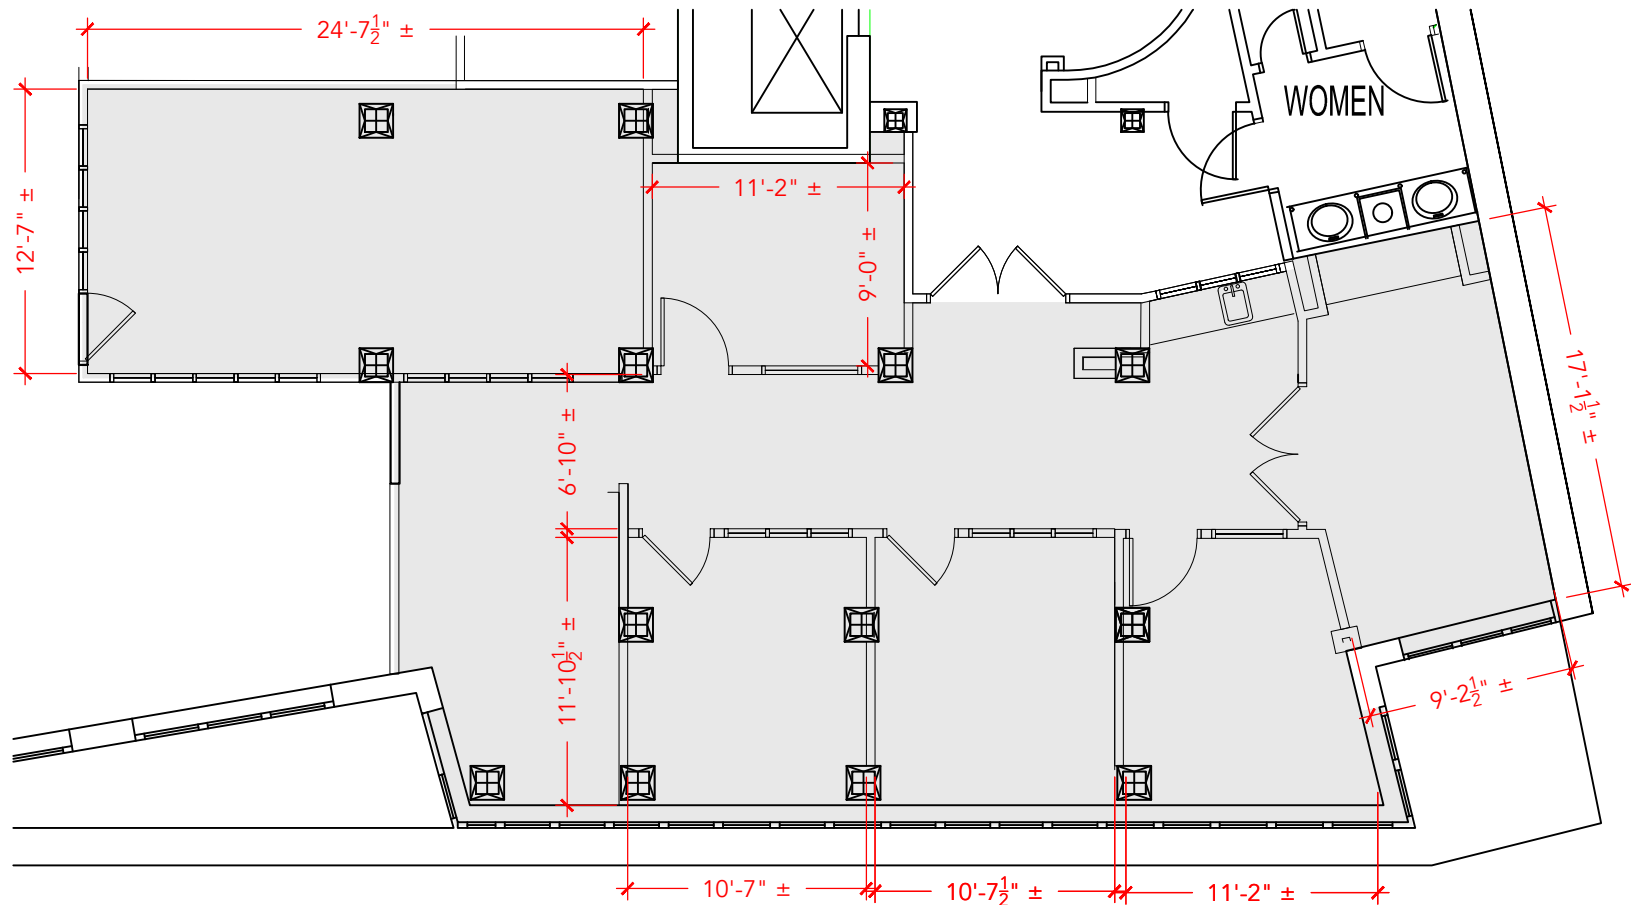

Floor Plan