
CCP 100 6011 UNIVERSITY BLVD ELLICOTT CITY, MD 21043 SUITE 470-490



Click to access3D model

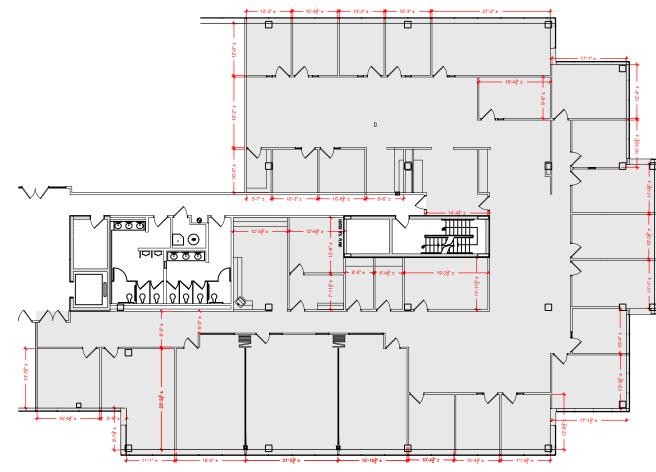

Floor Plan

Key Plan

merritt

PROPERTIES