


TOTAL SF AVAILABLE - 6,055 RSF

OFFICE 6,055 SF

WAREHOUSE - 0,000 SF

* % OF METER ROOM INCLUDED

[Click to access 3D model](#)

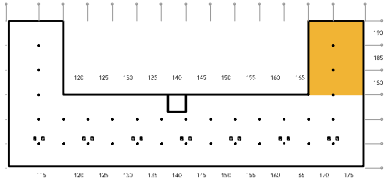

Key Plan



Floor Plan