


Key Plan

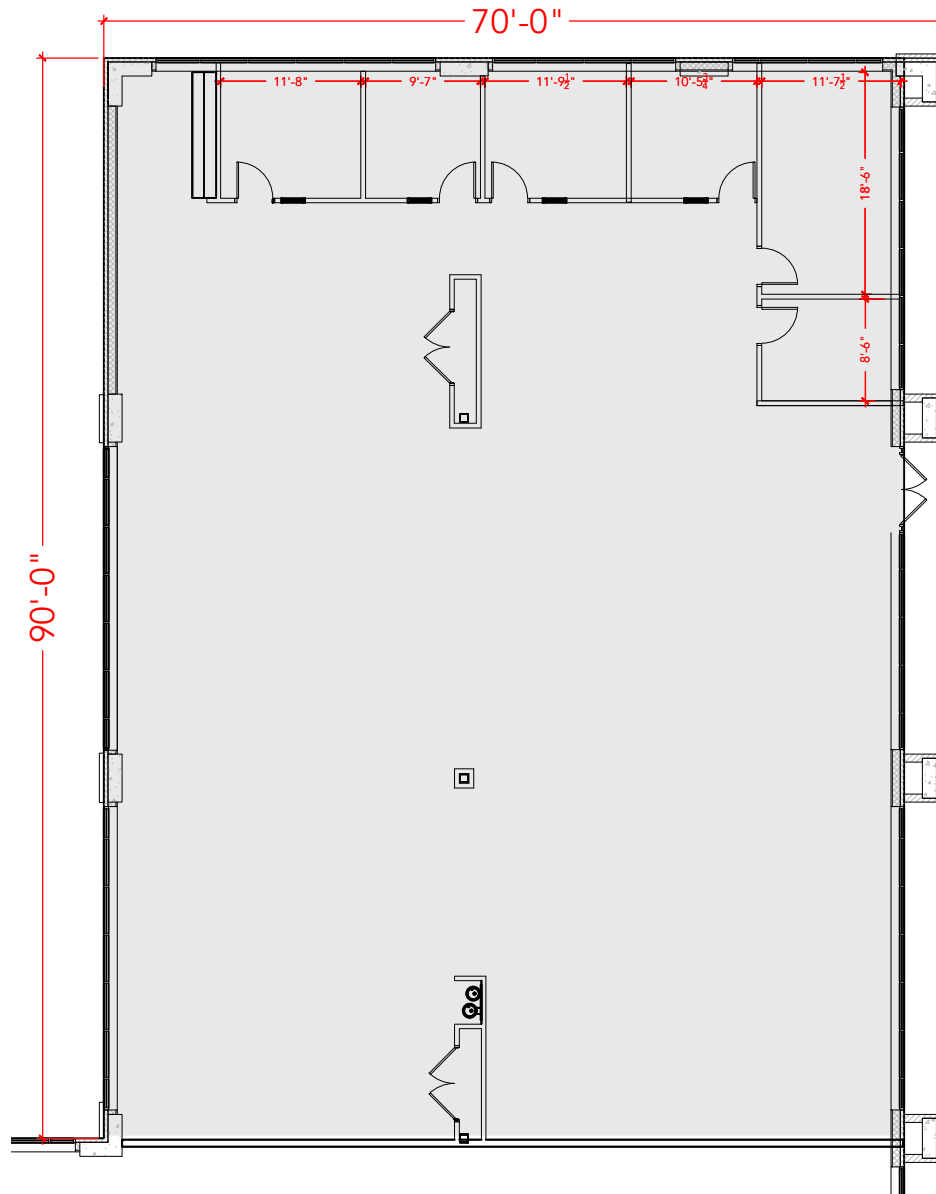

TOTAL SF AVAILABLE - 6,055 RSF

OFFICE 6,055 SF

WAREHOUSE - 0,000 SF

* % OF METER ROOM INCLUDED

[Click to access 3D model](#)

*RESTROOMS TO BE ADDED TO SUITE TO MEET BLDG CODES. LOCATION TBD BY FUTURE TENANT.

Floor Plan