


TOTAL SF AVAILABLE - 7,533 RSF(12.5%)

[Click to access 3D model](#)

Key Plan

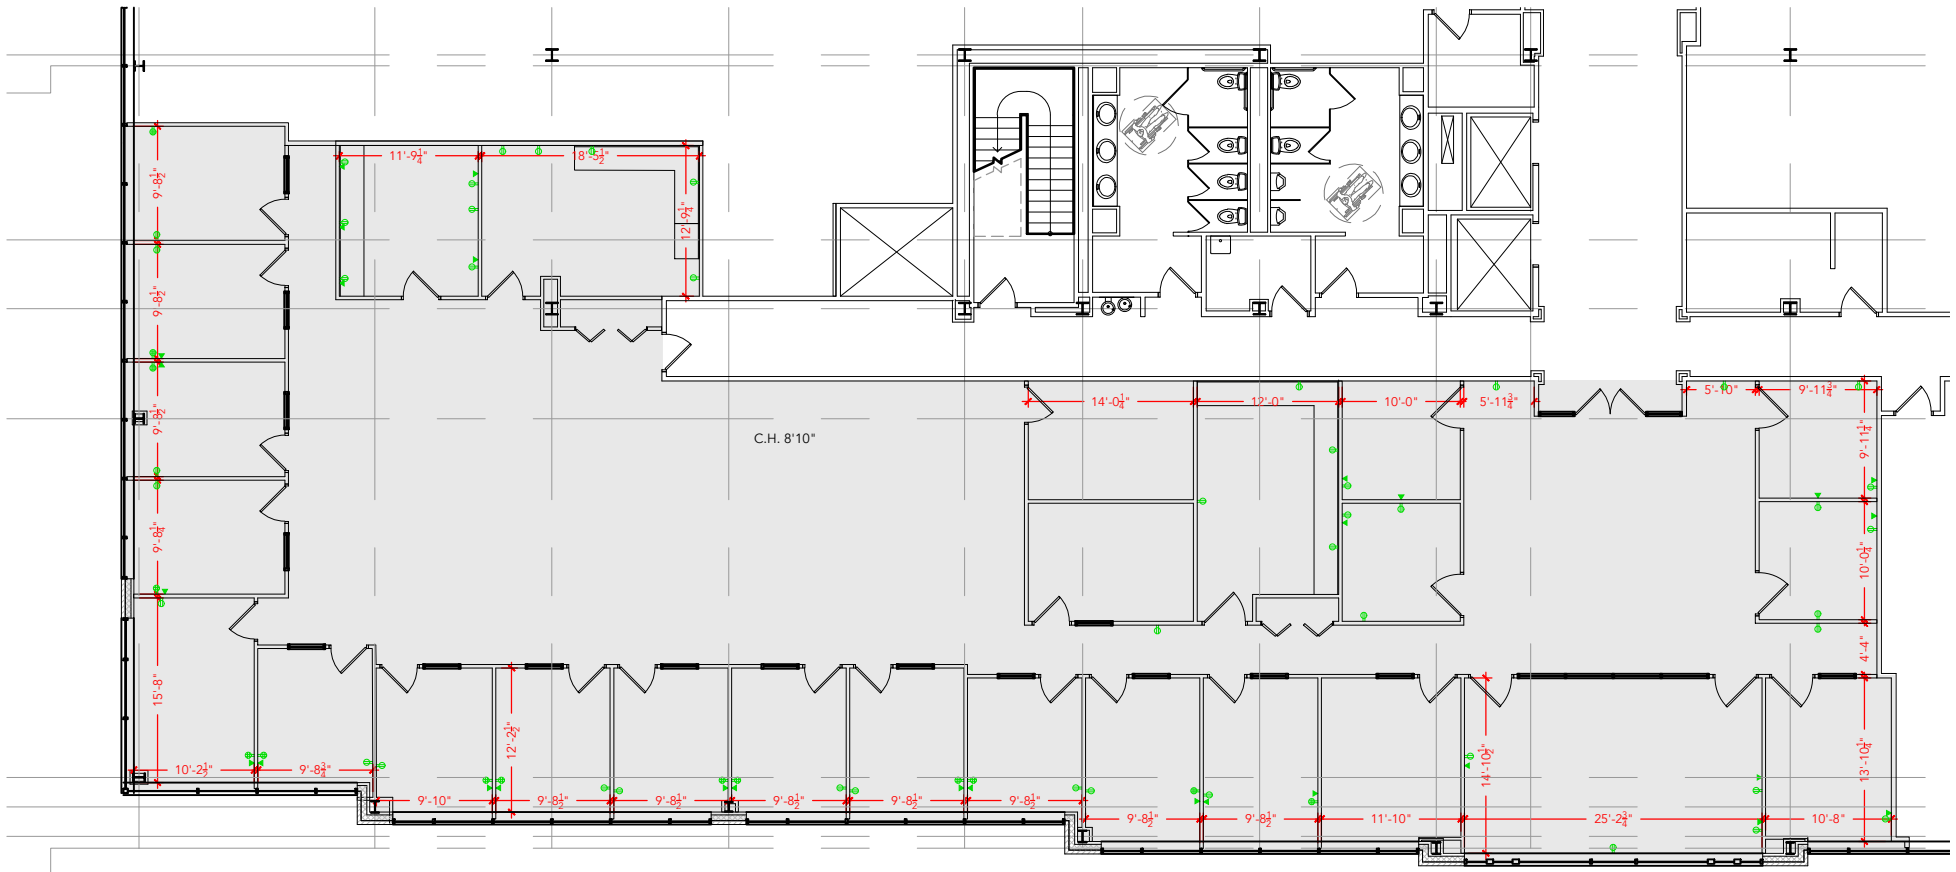

Floor Plan