


TOTAL SF AVAILABLE - 4,497 RSF(16%)

[Click to access 3D model](#)

Key Plan

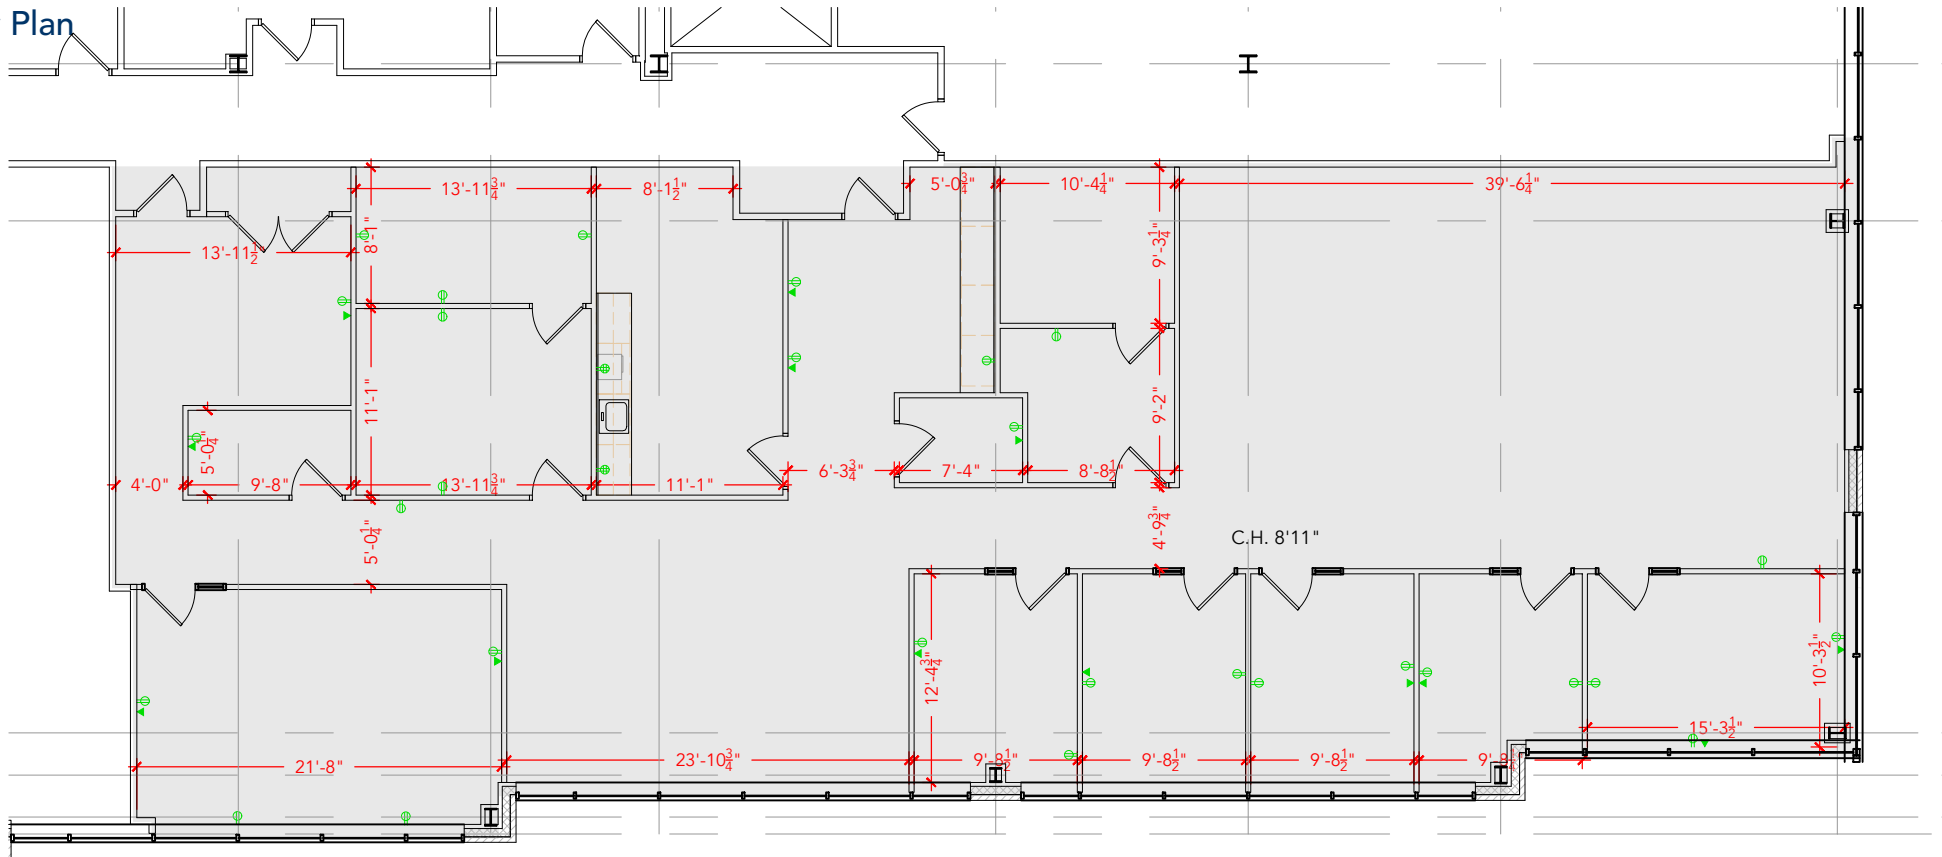

Floor Plan