


TOTAL SF AVAILABLE - 30,149 RSF

OFFICE - 4,910 RSF


WAREHOUSE SF - 25,239 RSF

TOTAL INCLUDES A % OF THE UTILITY RM

[Click to access3D model](#)

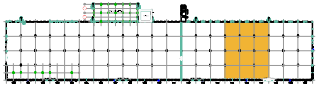

Key Plan

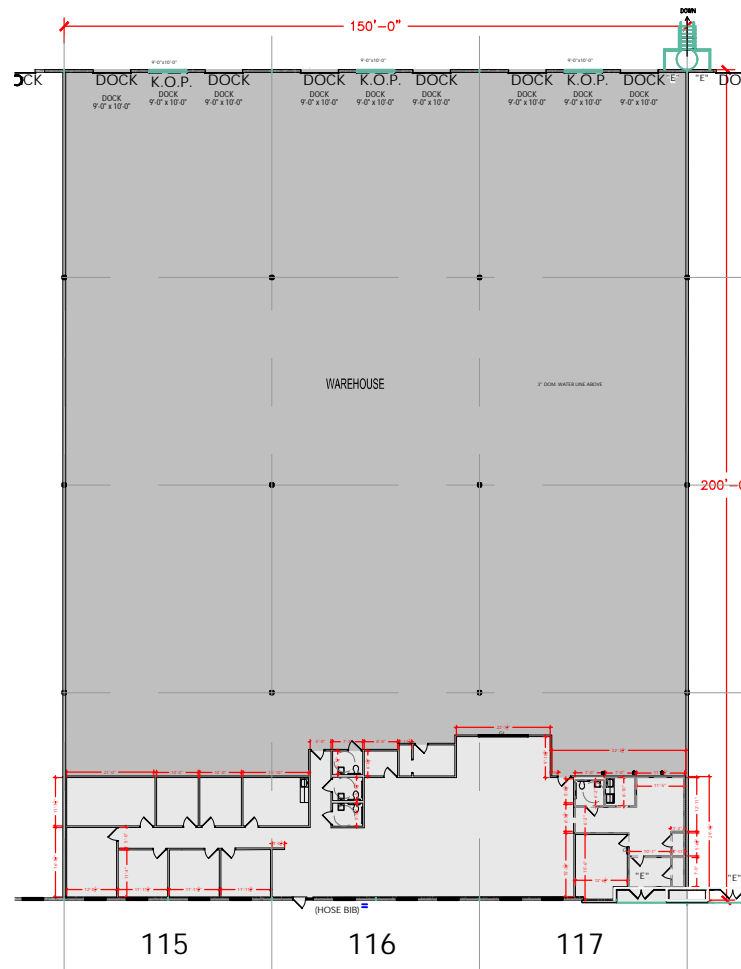

Floor Plan