



**TOTAL SF AVAILABLE -11,300 SF**

**OFFICE - 11,300 SF**  
**WAREHOUSE - 0,000 SF**

[Click to access 3D model](#)

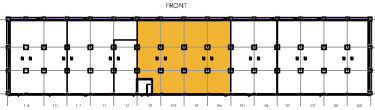

Key Plan

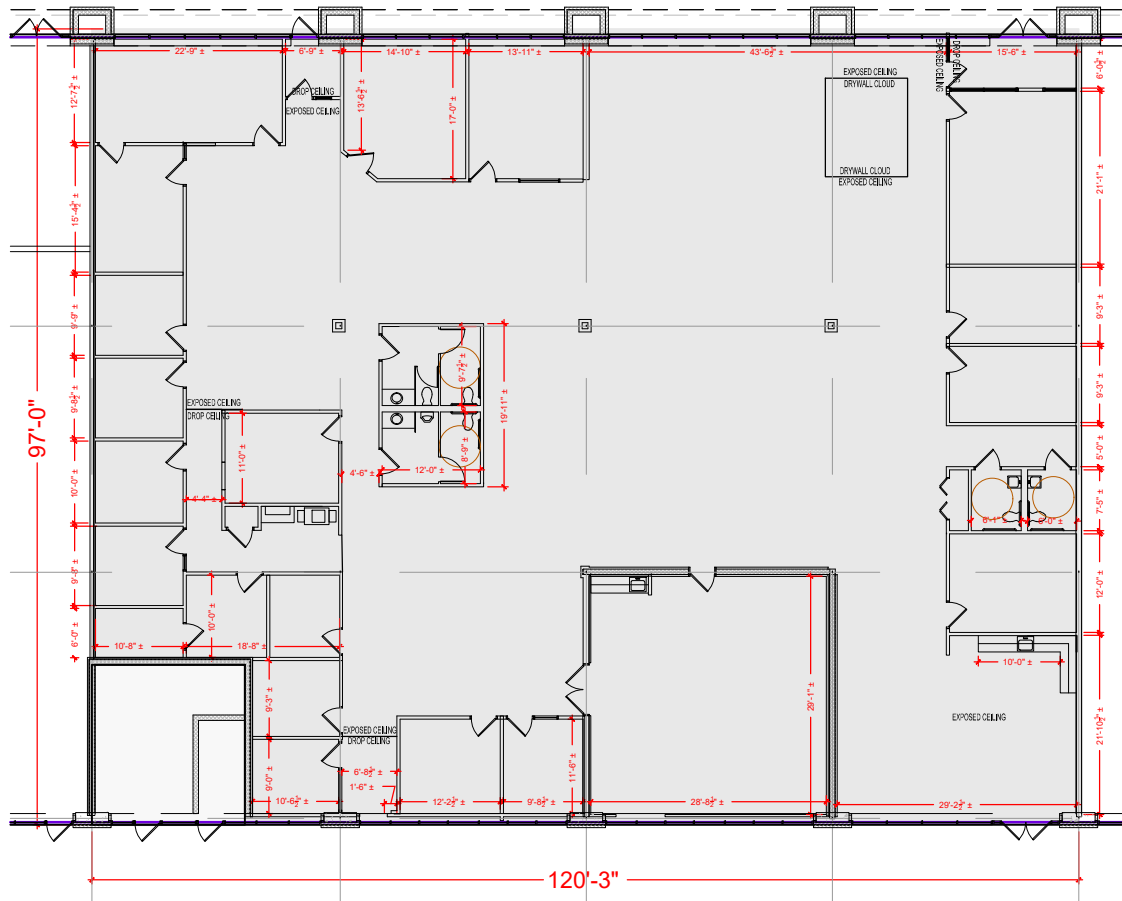

Floor Plan