



TOTAL SF AVAILABLE -4,050 SF

OFFICE - 1,127 SF  
WAREHOUSE - 2,923 SF

[Click to access CADD file](#)

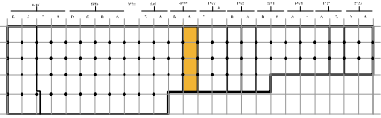

## Key Plan

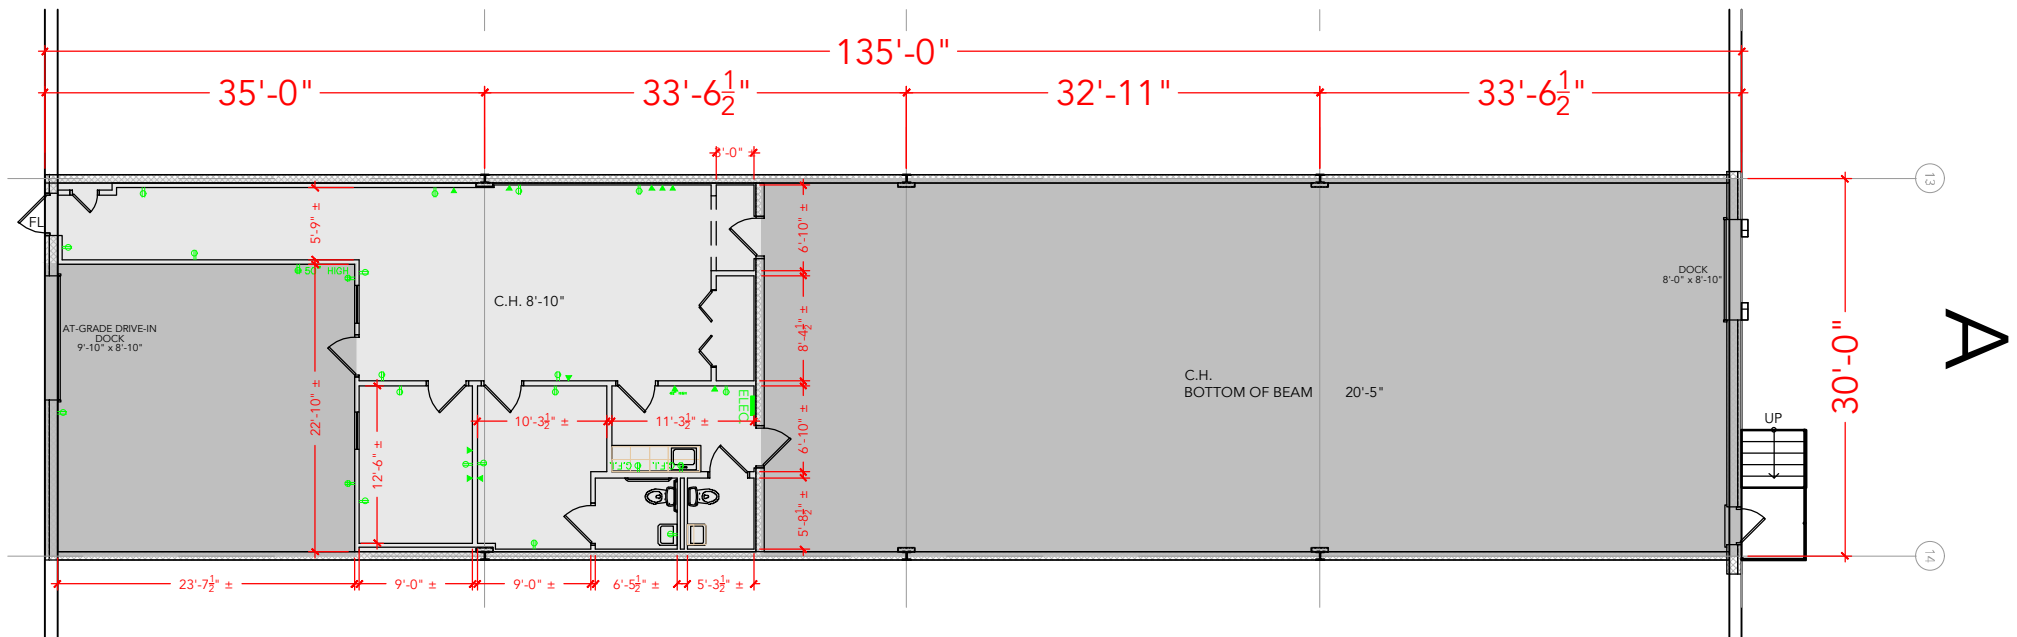

## Floor Plan