BEAUMEADE CORP. PARK BUILDING 5

44600 GUILDFORD DRIVE ASHBURN, VA 20147

SUITE 140-150

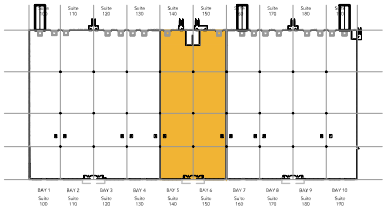

Key Plan

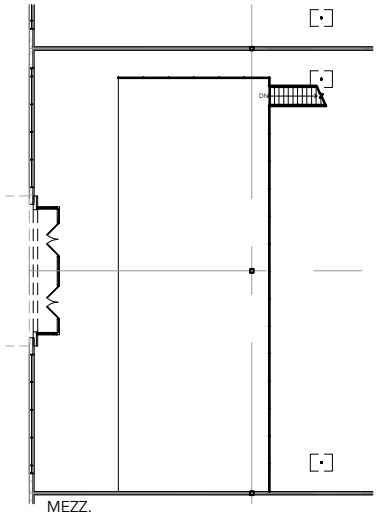

TOTAL SF AVAILABLE - 14,205 RSF

OFFICE - 1,268 RSF

WAREHOUSE - 12,937 RSF

* INCLUDED % OF METER ROOM

Click to access**3D** model

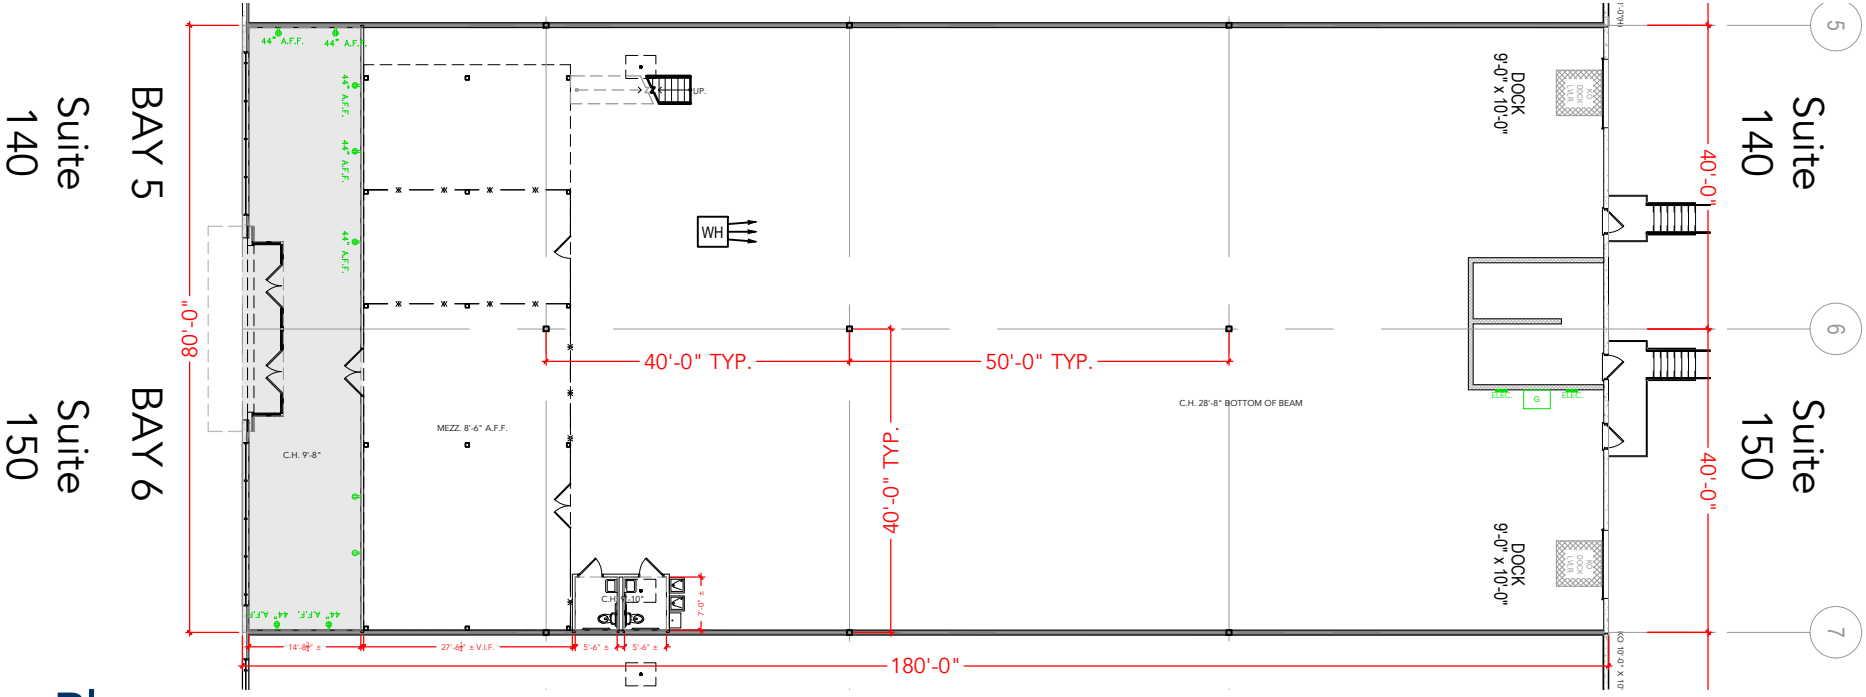

Floor Plan

PLAN NOT TO SCALE - THIS IS NOT A CONSTRUCTION DOCUMENT

DRAWING #: BM5-140-150 ASBUILT DATE: **03.11.24**