merritt PROPERTIES

729 EAST PRATT

729 EAST PRATT ST. BALTIMORE, MD 21202
SUITE 600-690

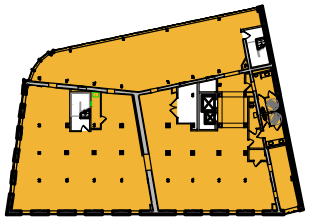

Key Plan

TOTAL SF AVAILABLE - 8,282 RSF(9%)

Click to access **3D** model

Floor Plan

PLAN NOT TO SCALE - THIS IS NOT A CONSTRUCTION DOCUMENT

DRAWING #: HA1-729-600-690 ASBUILT DATE: 05.07.21