merritt PROPERTIES

HIDDEN ROCK I

9305 GERWIG LANE COLUMBIA, MD 21046

SUITE Q-R

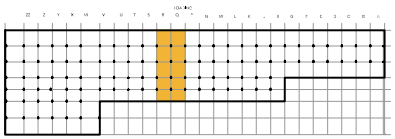

TOTAL SF AVAILABLE -9,000 SF

OFFICE - 3,073 SF

WAREHOUSE SF - 5,927 SF

Click to access **3D** model

Key Plan

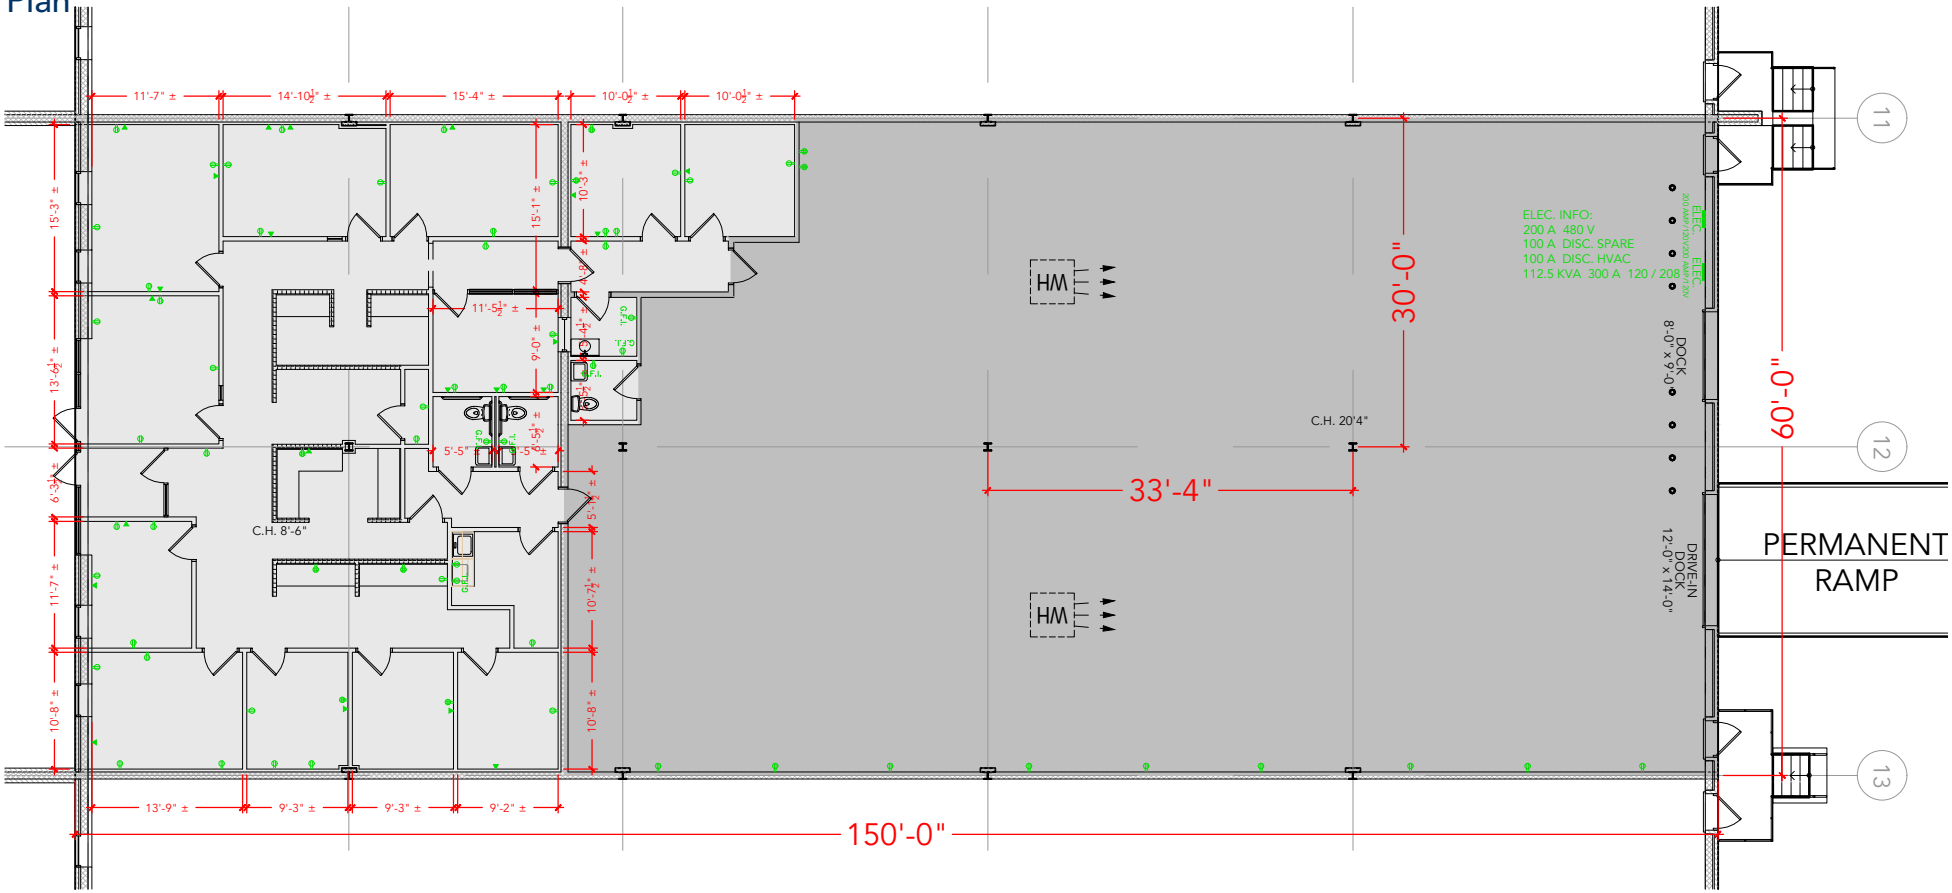

Floor Plan

PLAN NOT TO SCALE - THIS IS NOT A CONSTRUCTION DOCUMENT

DRAWING #: HR1-Q-R ASBUILT DATE: 03.29.24