INTERNATIONAL CIRCLE

303 INTERNATIONAL CIRCLE HUNT VALLEY, MD 21030
SUITE 160-180

TOTAL SF AVAILABLE - 6,093 RSF(12%)

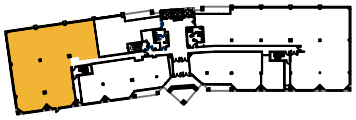

Click to access **3D** model

Key Plan

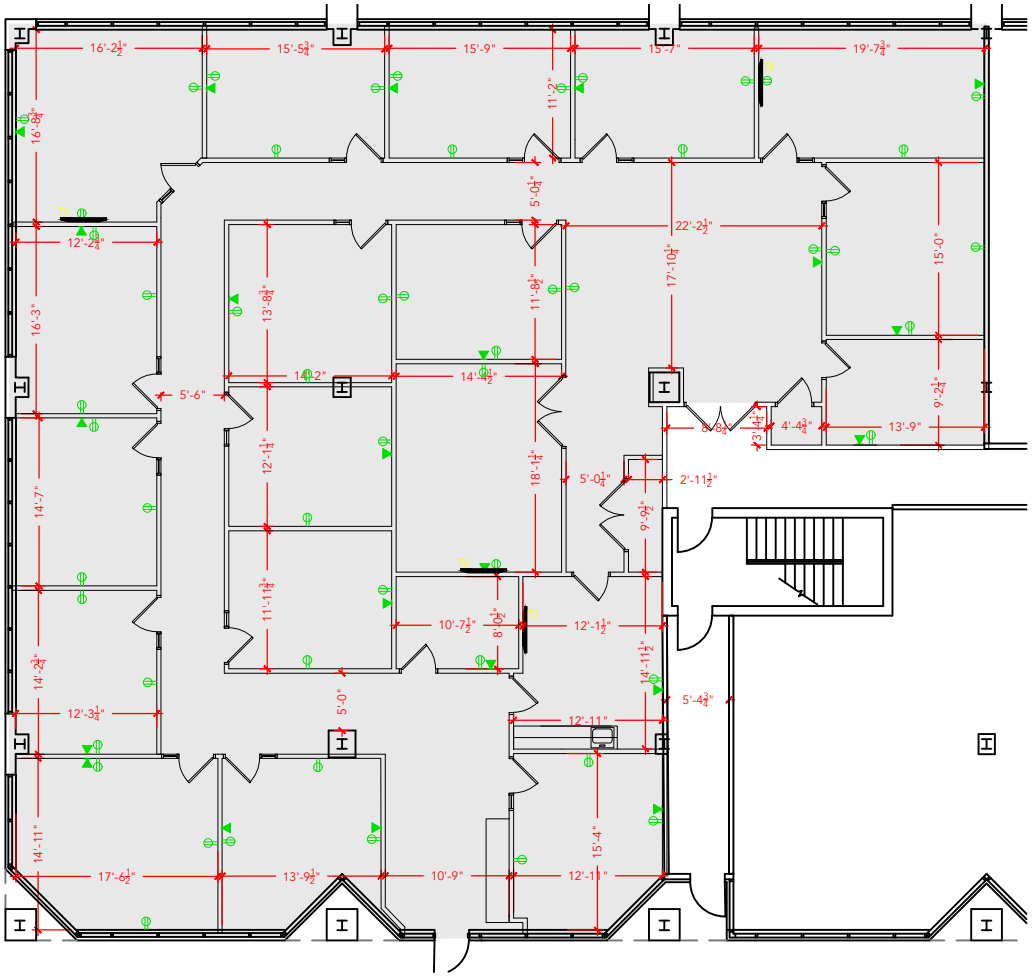

Floor Plan

PLAN NOT TO SCALE - THIS IS NOT A CONSTRUCTION DOCUMENT

DRAWING #: IC1-160-180 ASBUILT DATE: 06.10.14