MEADOWRIDGE 95 - BUILDING 2

6518 MEADOWRIDGE RD ELKRIDGE, MD 21075

SUITE 214-220

TOTAL SF AVAILABLE - 5,690 RSF(16%)

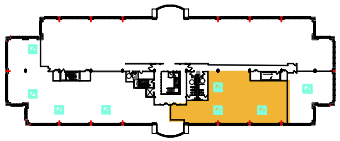

Click to access **3D** model

Key Plan

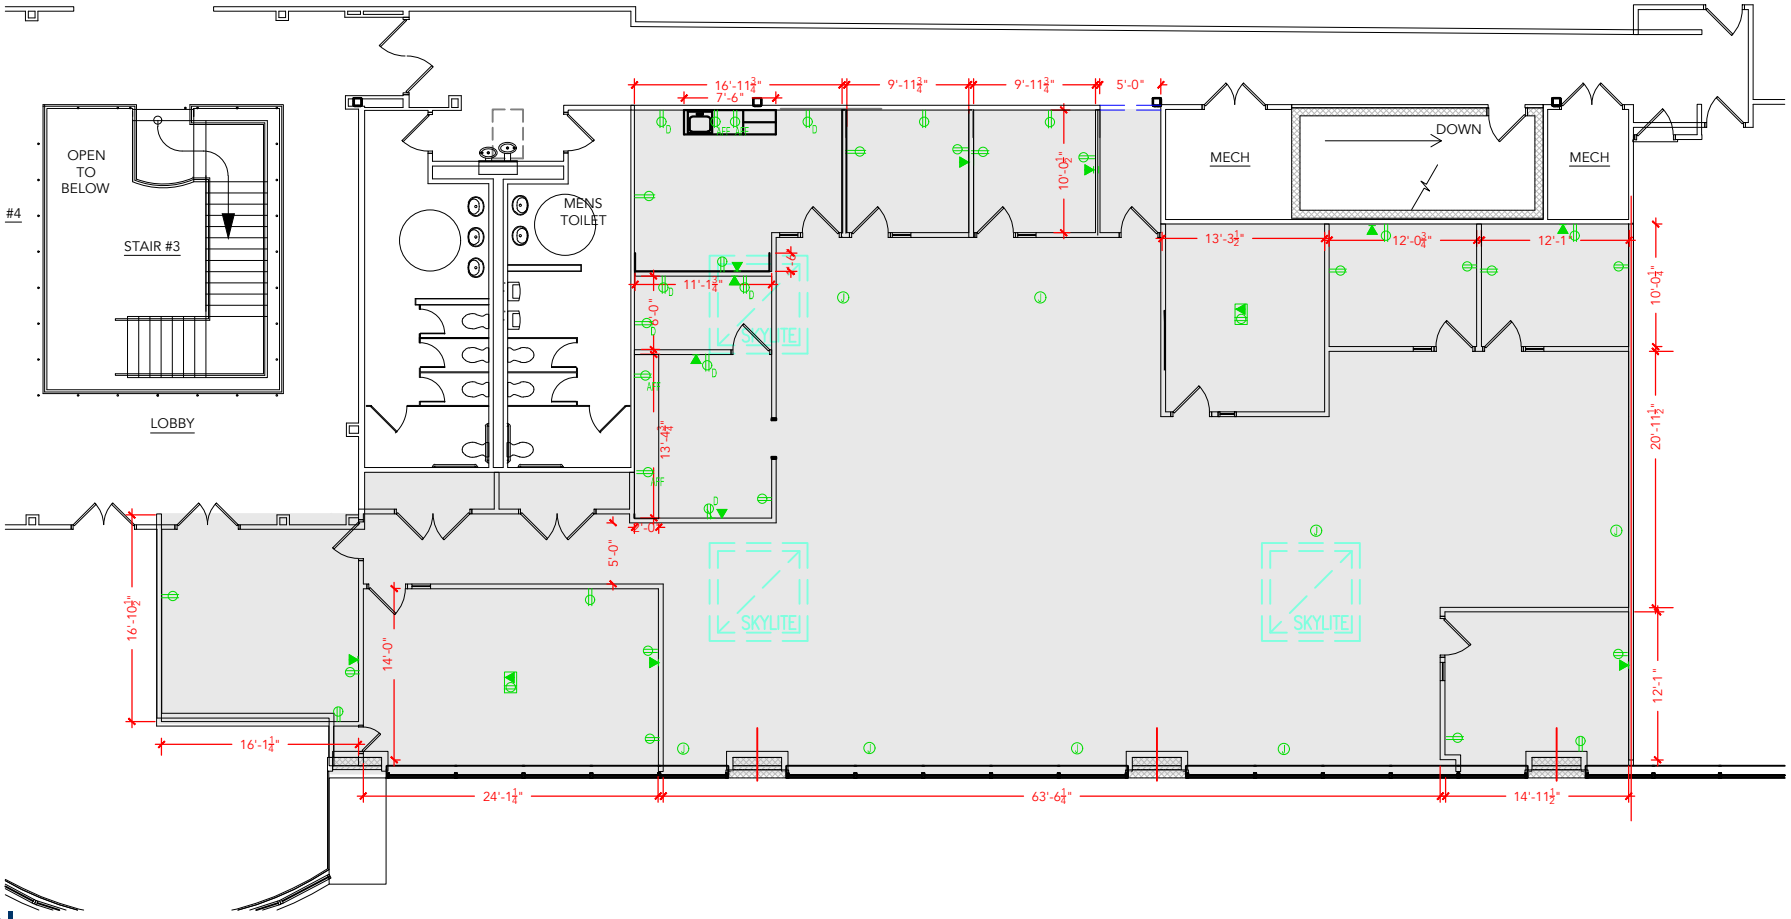

Floor Plan

PLAN NOT TO SCALE - THIS IS NOT A CONSTRUCTION DOCUMENT

DRAWING #: MR2-214-220 ASBUILT DATE: **NEEDS TO BE**