729 East Pratt

720 East Pratt Street
Suites 800-850
Baltimore, MD 21202

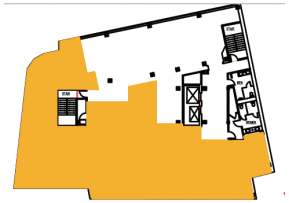

Building Key Plan

Total SF Office Available
4,781 RSF

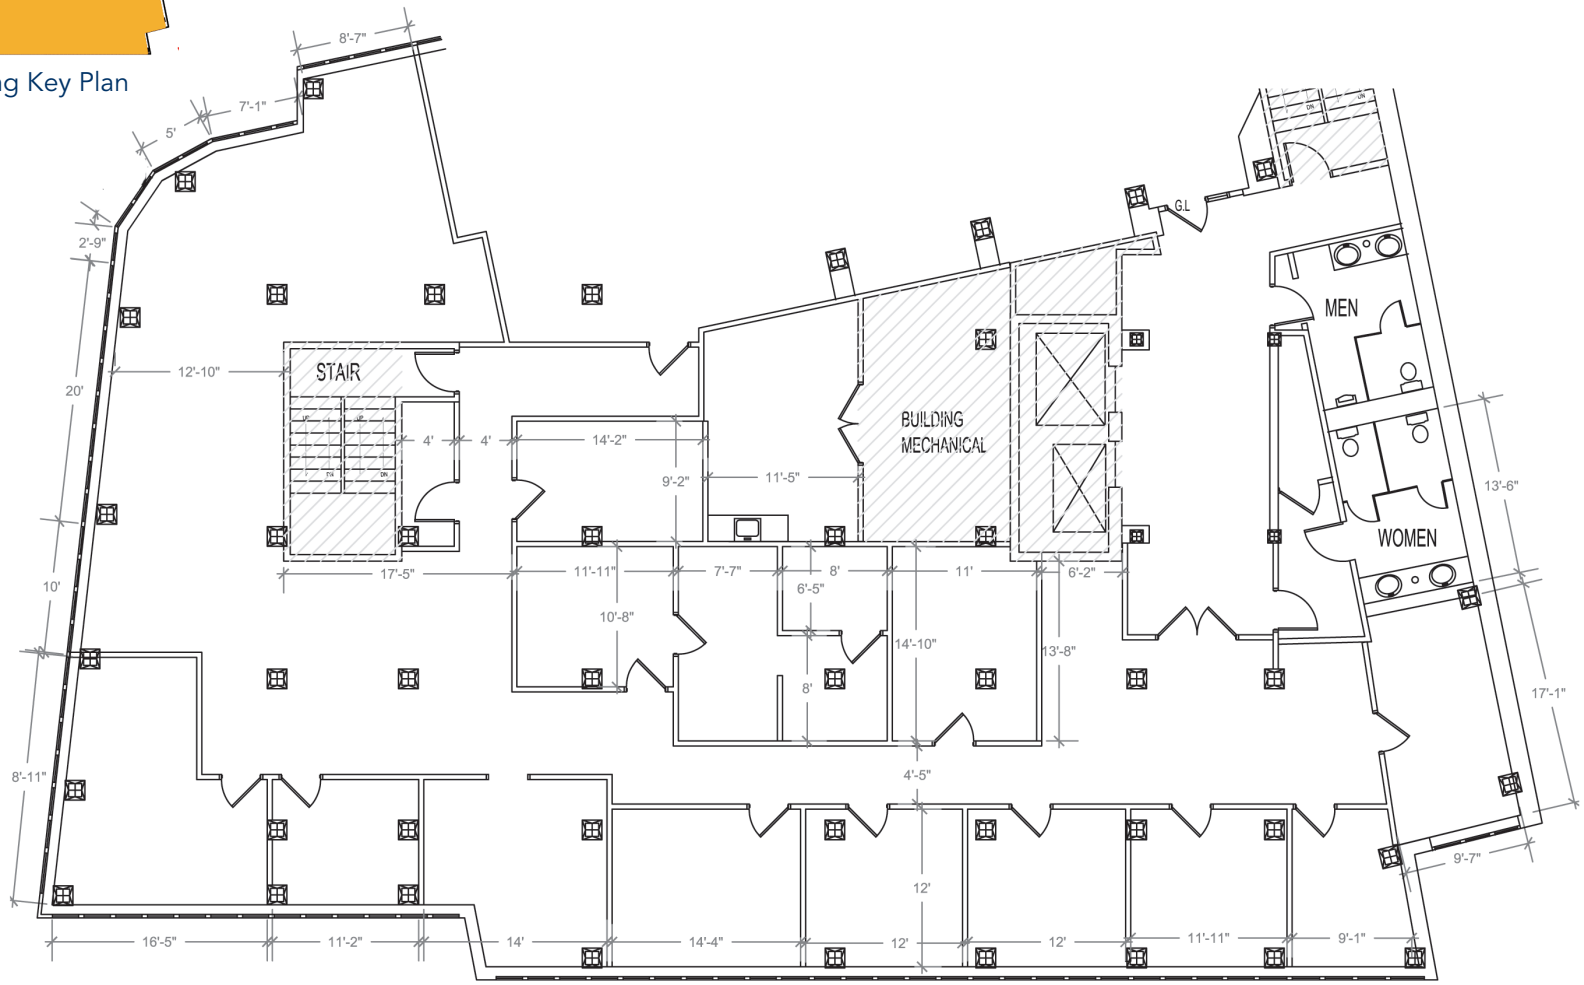

Plan not to scale - this is not a construction document.