Columbia Corporate Park

8850 Stanford Boulevard
Suite 2900
Columbia, MD 21045

Building Key Plan

Total SF Office Available
2,862 RSF

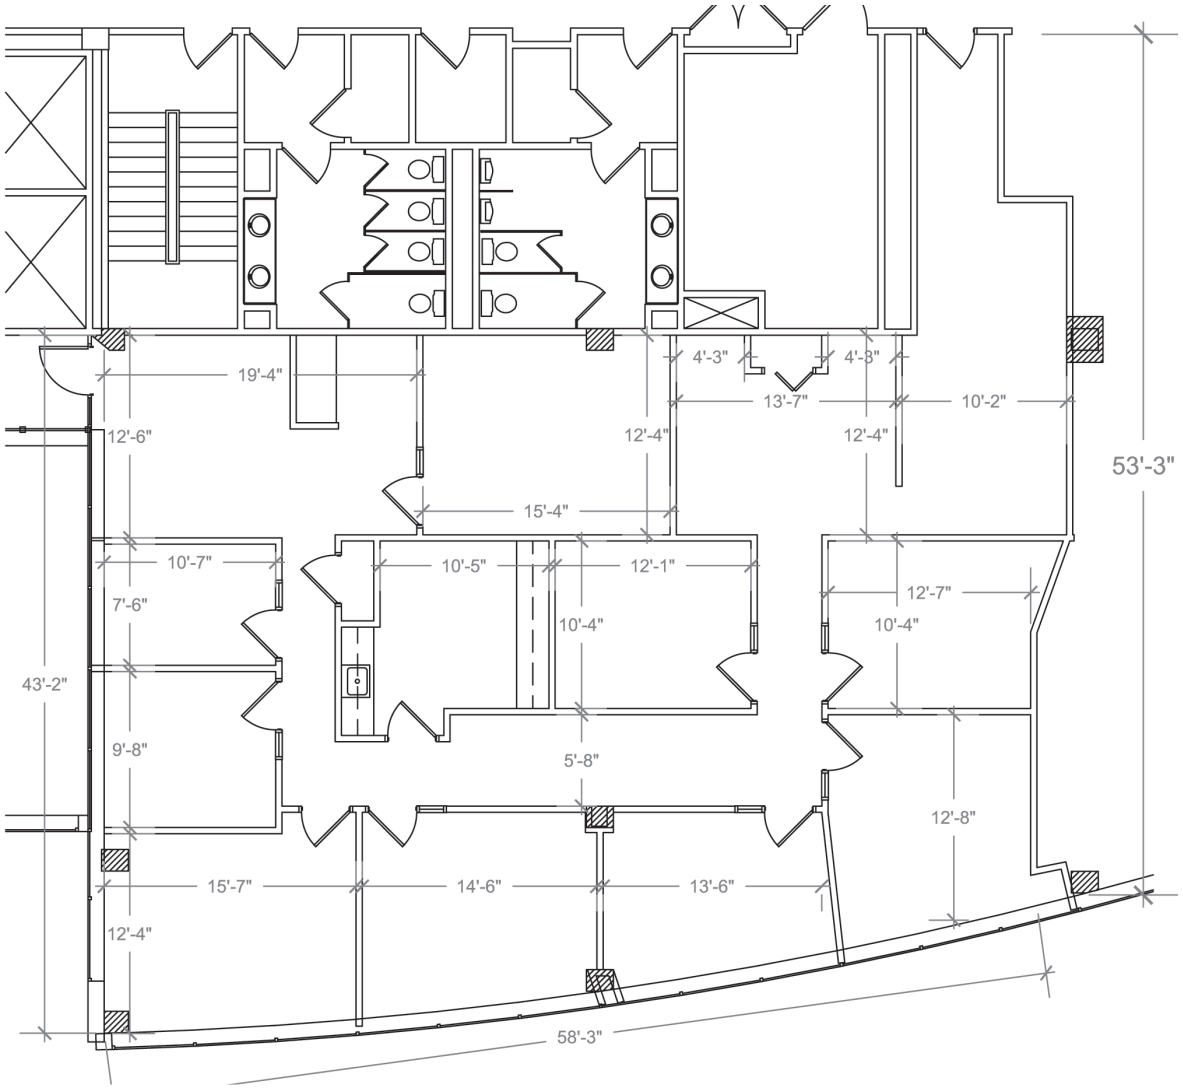

Plan not to scale - this is not a construction document.