# 230 SCHILLING CIRCLE

230 SCHILLING CIRCLE, HUNT VALLEY, MD 21031
SUITE 240-274

## TOTAL SF AVAILABLE - 18,891 RSF(12%)

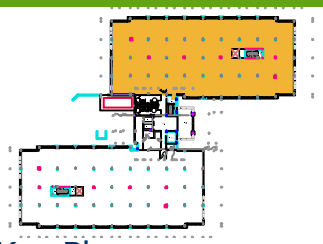

Key Plan

Click to access **3D** model

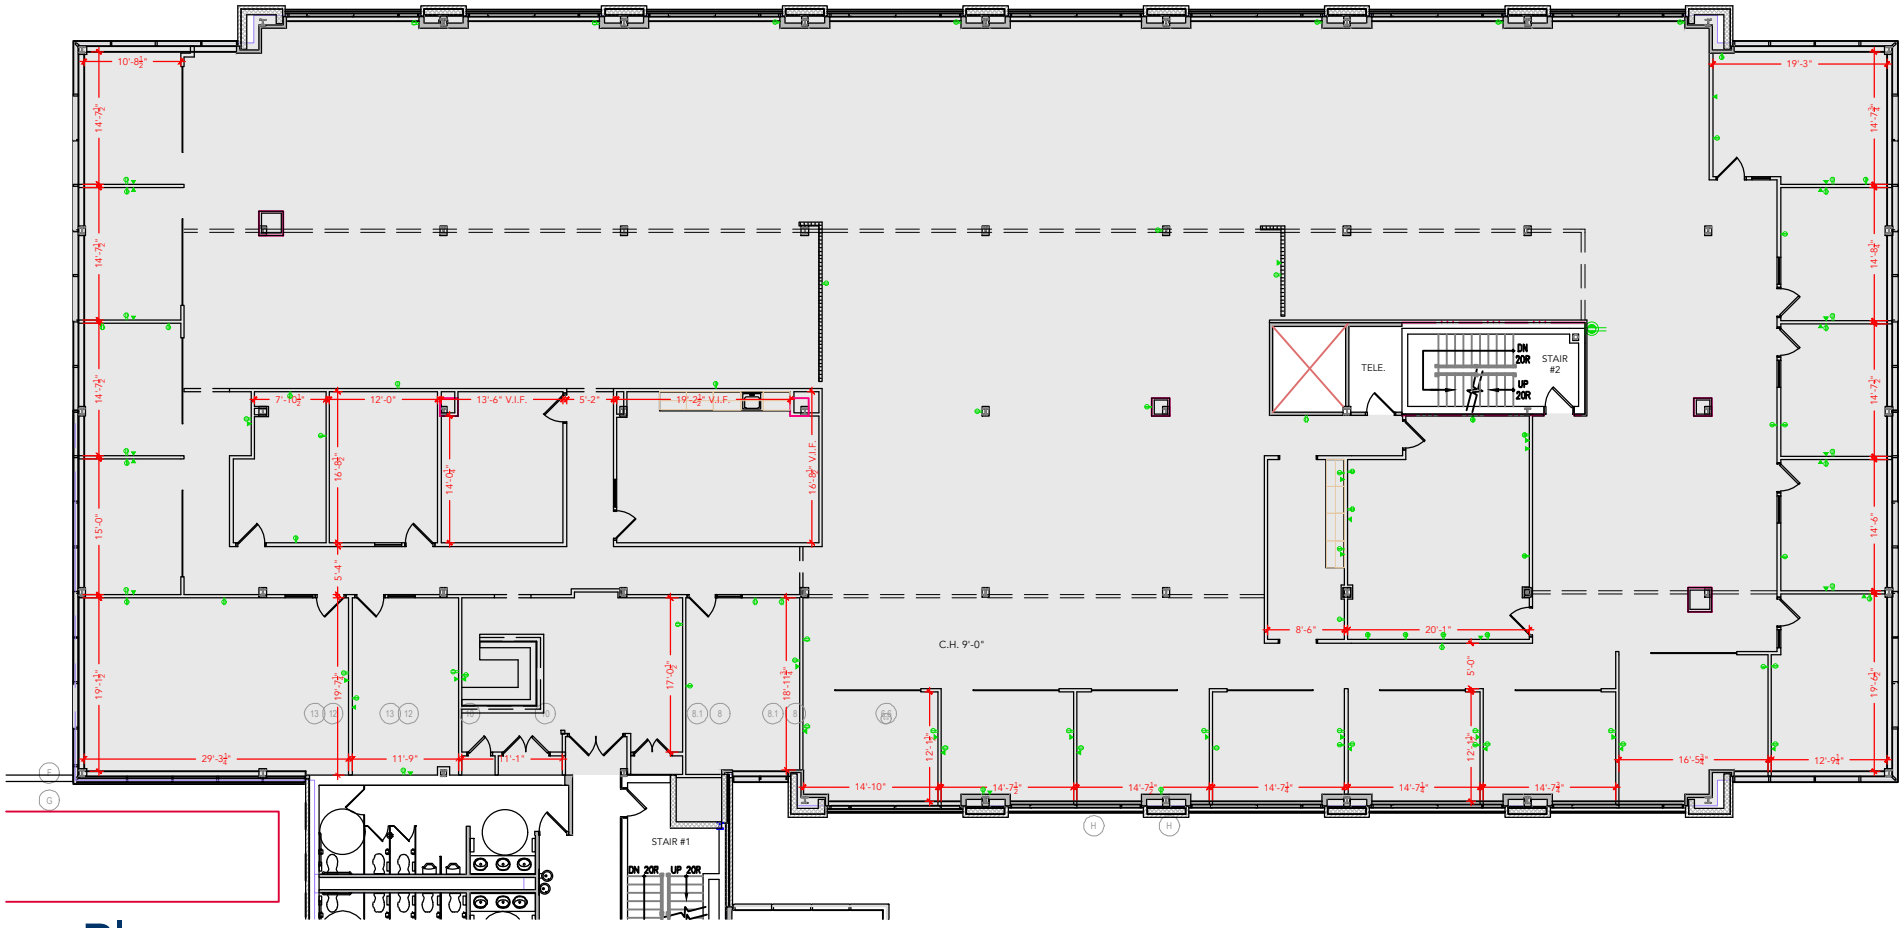


Floor Plan

PLAN NOT TO SCALE - THIS IS NOT A CONSTRUCTION DOCUMENT

DRAWING #: SC10-240-274 ASBUILT DATE:10.27.20