TIMONIUM TWO

1954 GREENSPRING DRIVE TIMONIUM, MD 21093

SUITE 555-595

TOTAL SF AVAILABLE - 13,862 RSF(12%)

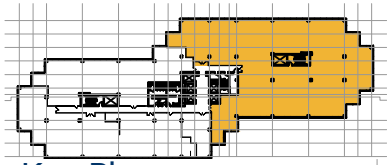

Key Plan

Click to access**3D** model

Click to view space Photos

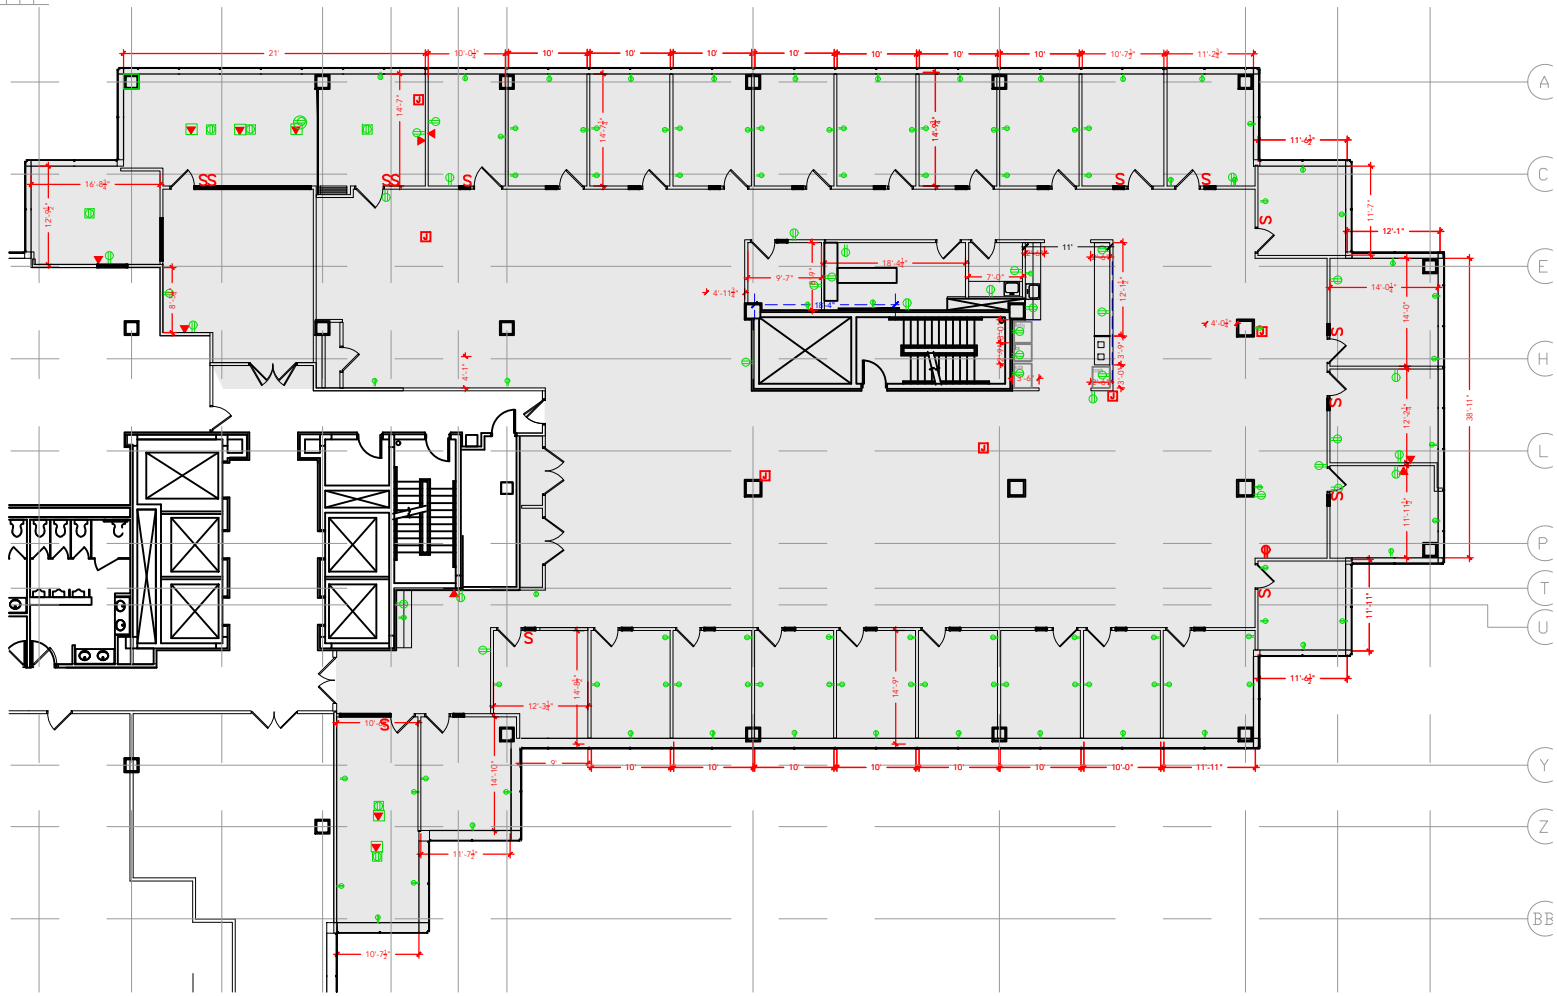

Floor Plan

PLAN NOT TO SCALE - THIS IS NOT A CONSTRUCTION DOCUMENT

DRAWING #: TD4-555-595 ASBUILT DATE: **NEEDS TO BE**