LANSDOWNE INDUSTRIAL PARK

178-186 ALCO PLACE BALTIMORE, MD 21227

merritt PROPERTIES

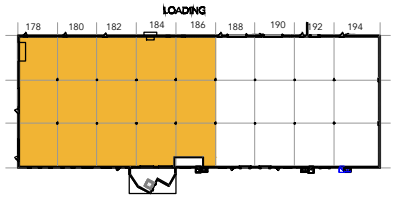

Key Plan

TOTAL SF AVAILABLE -14,811 SF

OFFICE - 1,744 SF

WAREHOUSE - 13,067 SF

Click to access **CADD file**

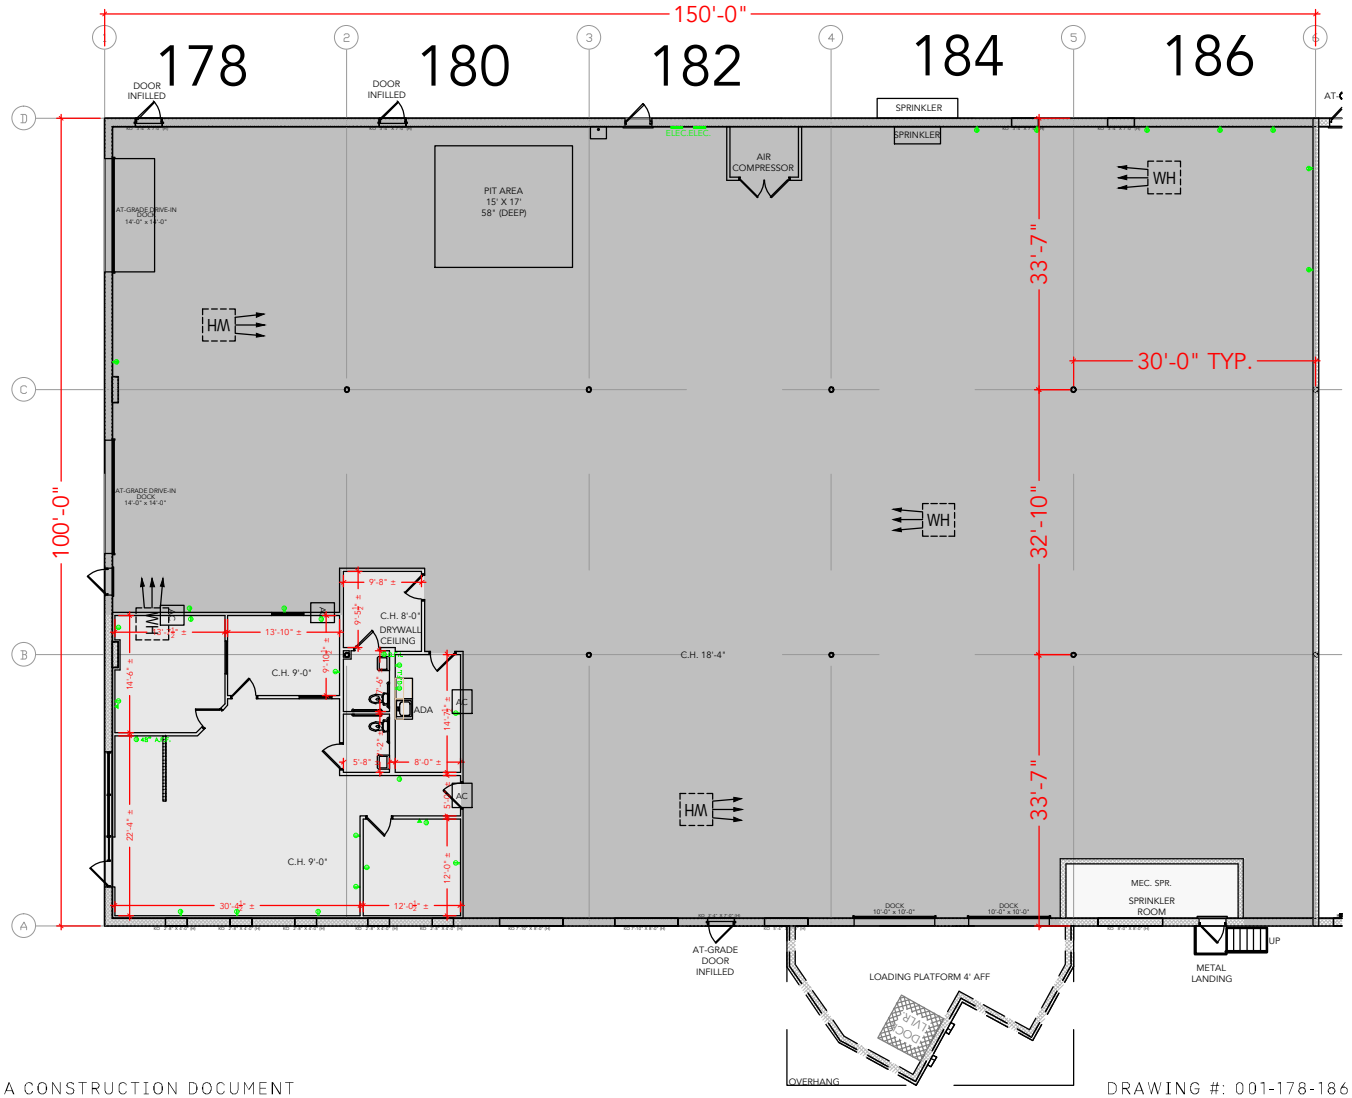

Floor Plan

PLAN NOT TO SCALE - THIS IS NOT A CONSTRUCTION DOCUMENT

DRAWING #: 001-178-186 ASBUILT DATE: **08.21.25**