WINDSOR CORPORATE PARK

2601 ROLLING ROAD BALTIMORE, MD 21244

SUITE 105

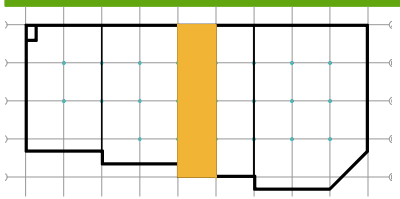

TOTAL SF AVAILABLE - 3,600 SF

OFFICE - 1,784 SF

WAREHOUSE SF - 1,816 SF

Click to access **3D** model

Key Plan

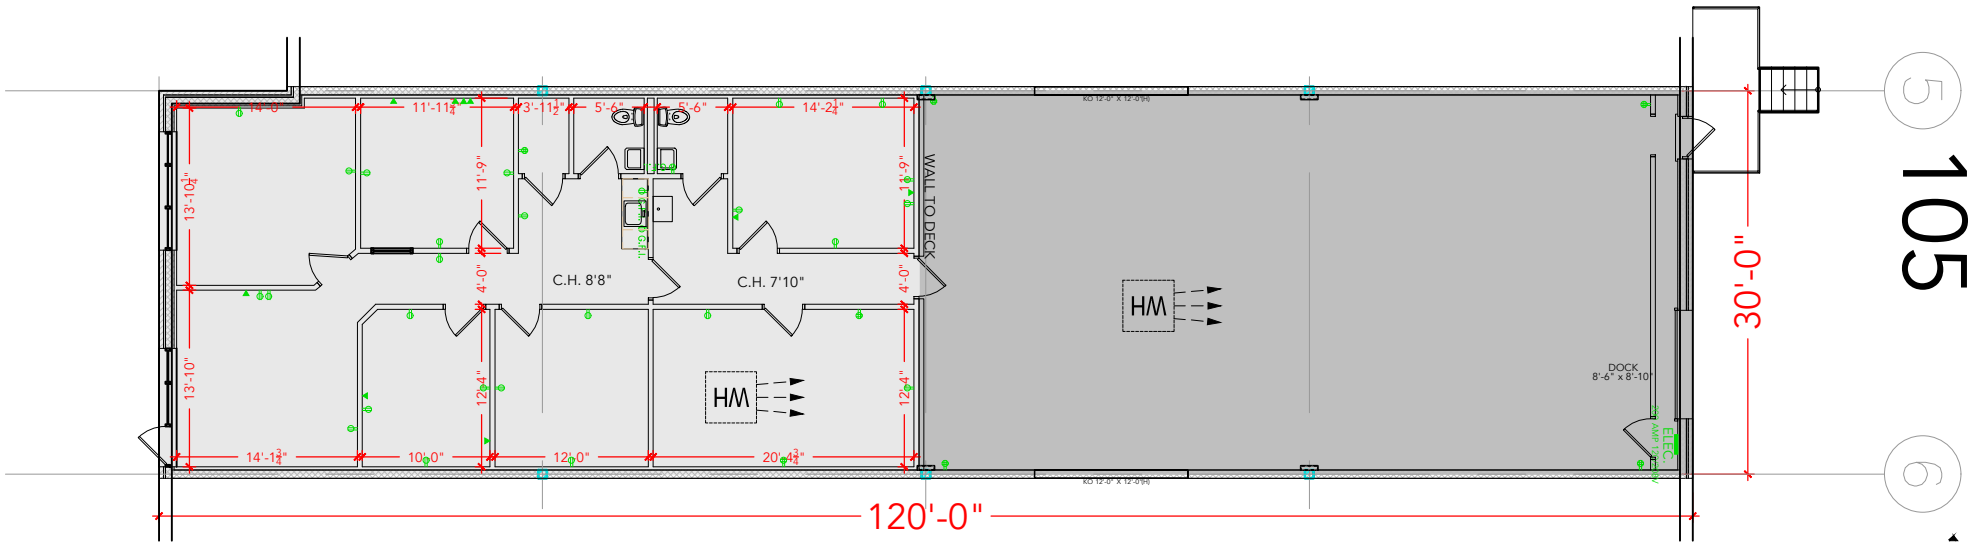

Floor Plan

PLAN NOT TO SCALE - THIS IS NOT A CONSTRUCTION DOCUMENT

DRAWING #: 002-2601-105 ASBUILT DATE: **05.07.2020**