WINDSOR CORPORATE PARK

2603 ROLLING ROAD BALTIMORE, MD 21244

SUITE 306-307

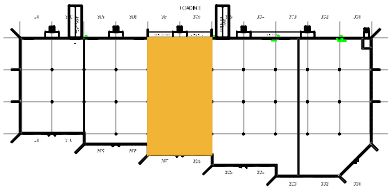

Key Plan

TOTAL SF AVAILABLE -6,614 RSF

OFFICE - 1,481 RSF

WAREHOUSE - 5,133 RSF

* INCLUDES % OF METER ROOM

Click to access **CADD file**

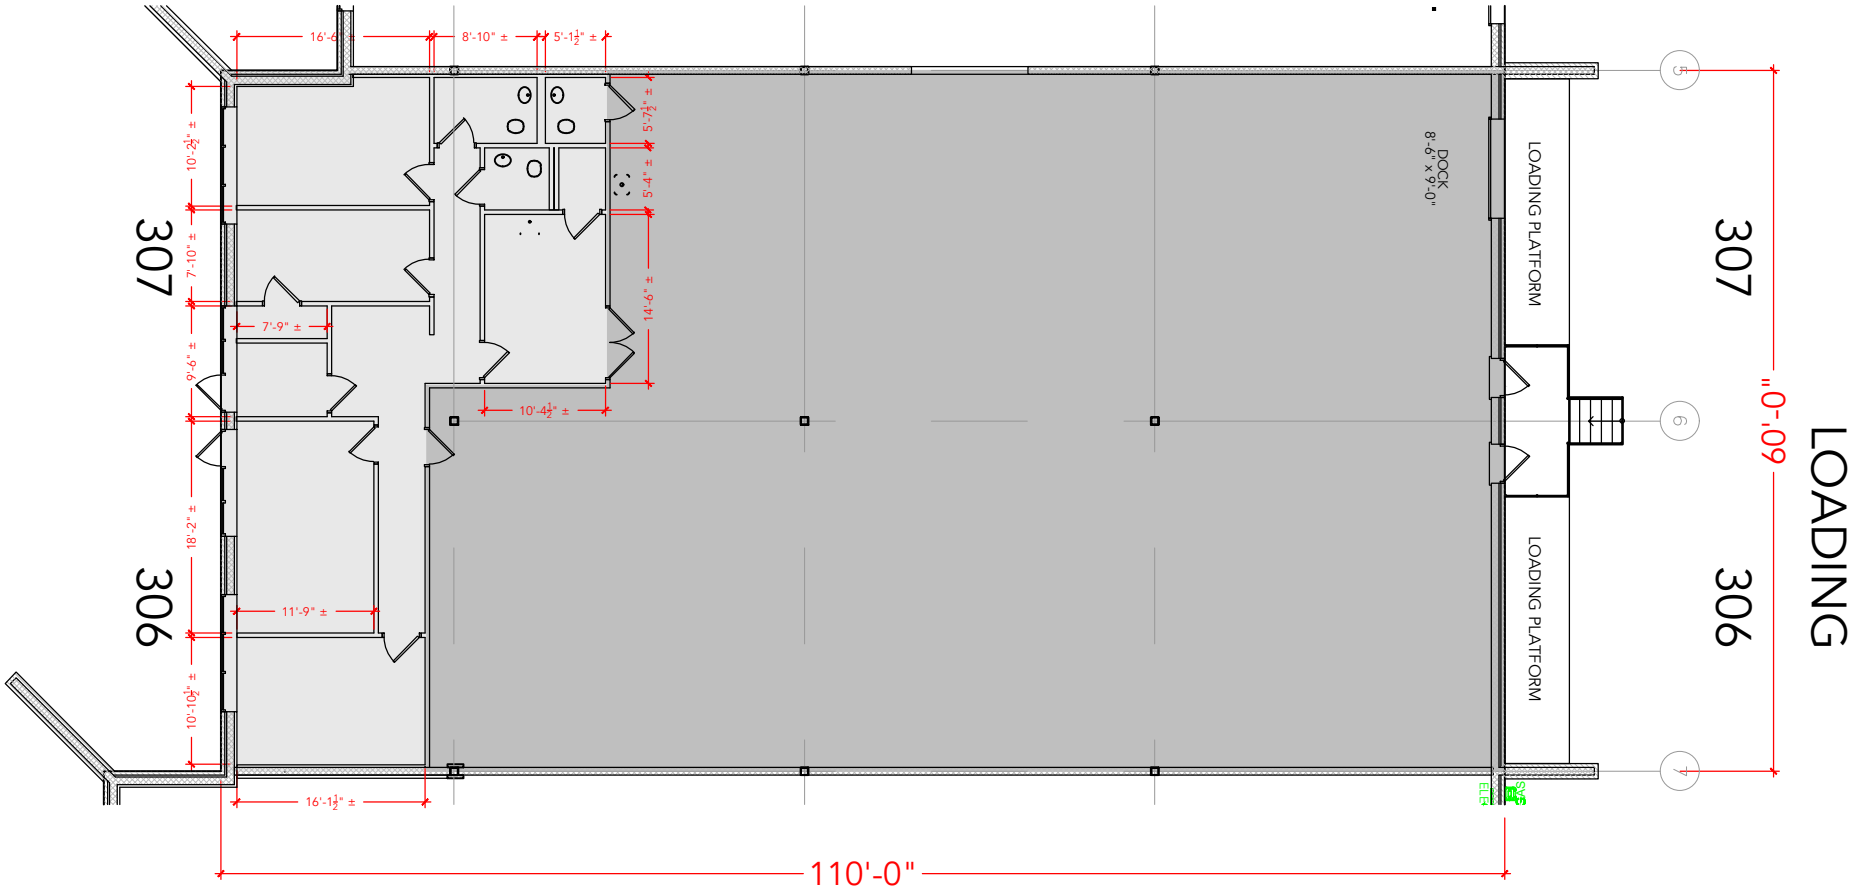

Floor Plan

PLAN NOT TO SCALE - THIS IS NOT A CONSTRUCTION DOCUMENT

DRAWING #: 002-2603-306-307 ASBUILT DATE: **NEEDS TO BE**