TOWSON BUSINESS CENTER

8741 (R) MYLANDER LANE, TOWSON, MD 21286

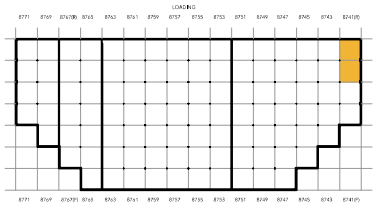

Key Plan

TOTAL SF AVAILABLE -1,800 SF

OFFICE - 1,800 SF

WAREHOUSE SF - 0,000 SF

Click to access **3D** model

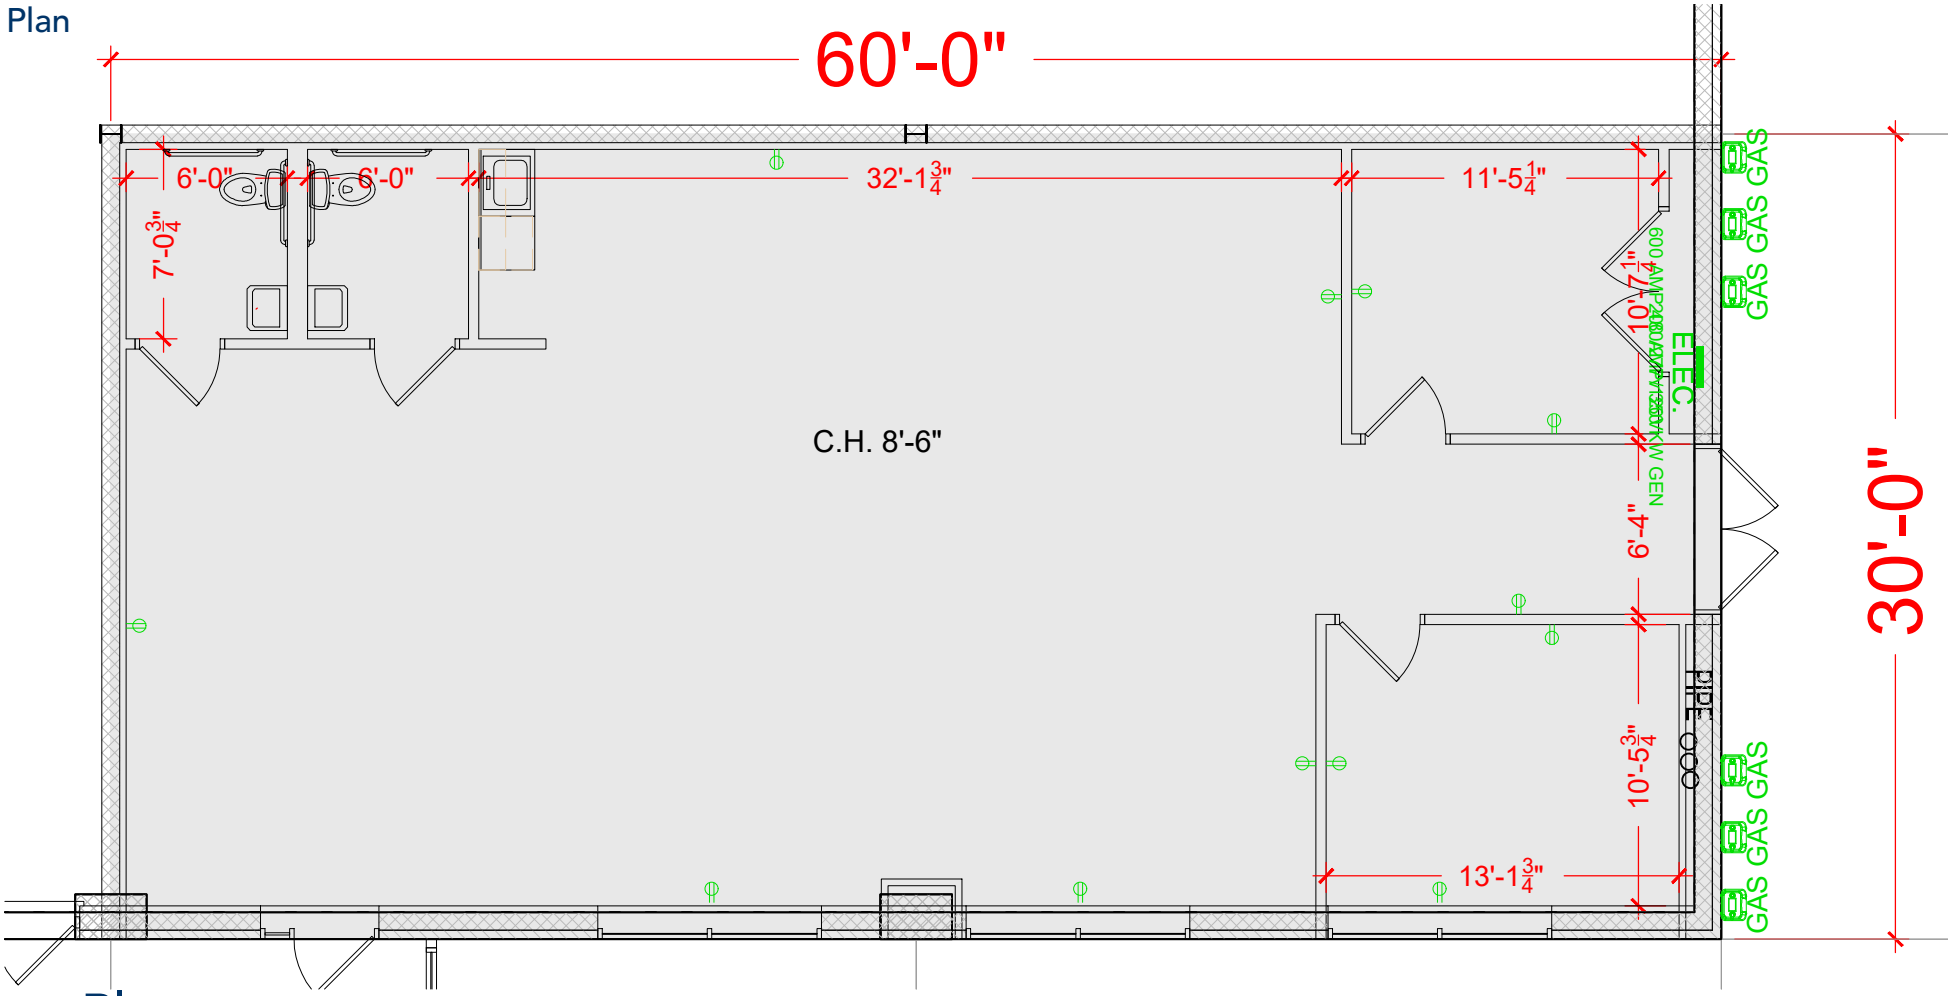

Floor Plan

PLAN NOT TO SCALE - THIS IS NOT A CONSTRUCTION DOCUMENT

DRAWING #: 025-8741(R) ASBUILT DATE:10.09.20