SETON BUSINESS PARK

4820 SETON DR. BALTIMORE, MD 21215

SUITE F-G

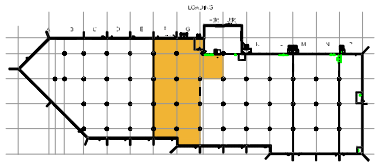

TOTAL SF AVAILABLE -9,217 RSF

OFFICE - 2,772 RSF

WAREHOUSE - 6,445 RSF

* INCLUDES % OF METER ROOM

Click to access **CADD file**

Key Plan

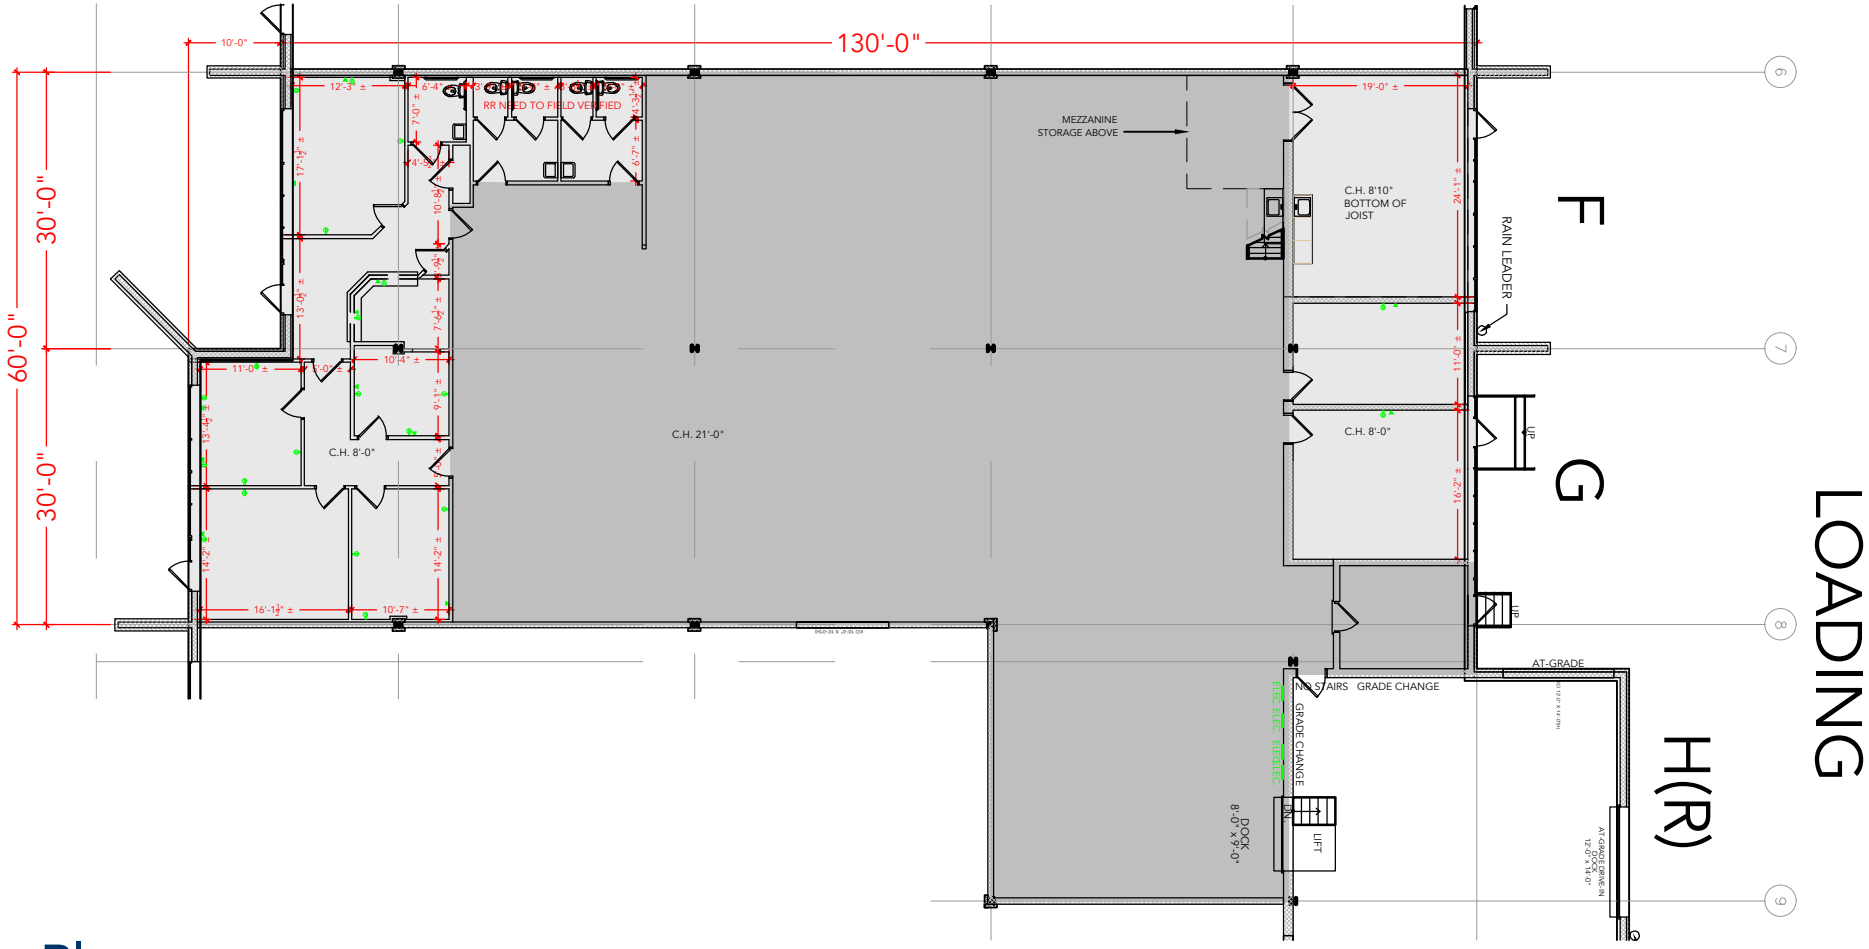

Floor Plan

PLAN NOT TO SCALE - THIS IS NOT A CONSTRUCTION DOCUMENT

DRAWING #: 072-F-G ASBUILT DATE: **05.24.2021**