# SETON BUSINESS PARK

4820 SETON DR. BALTIMORE, MD 21215

SUITE F-J(R)

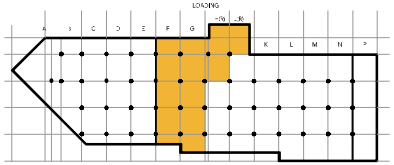

## TOTAL SF AVAILABLE -11,051 RSF

OFFICE - 2,875 RSF

WAREHOUSE - 8,176 RSF

* INCLUDES % OF METER ROOM

Click to access **CADD file**

Key Plan

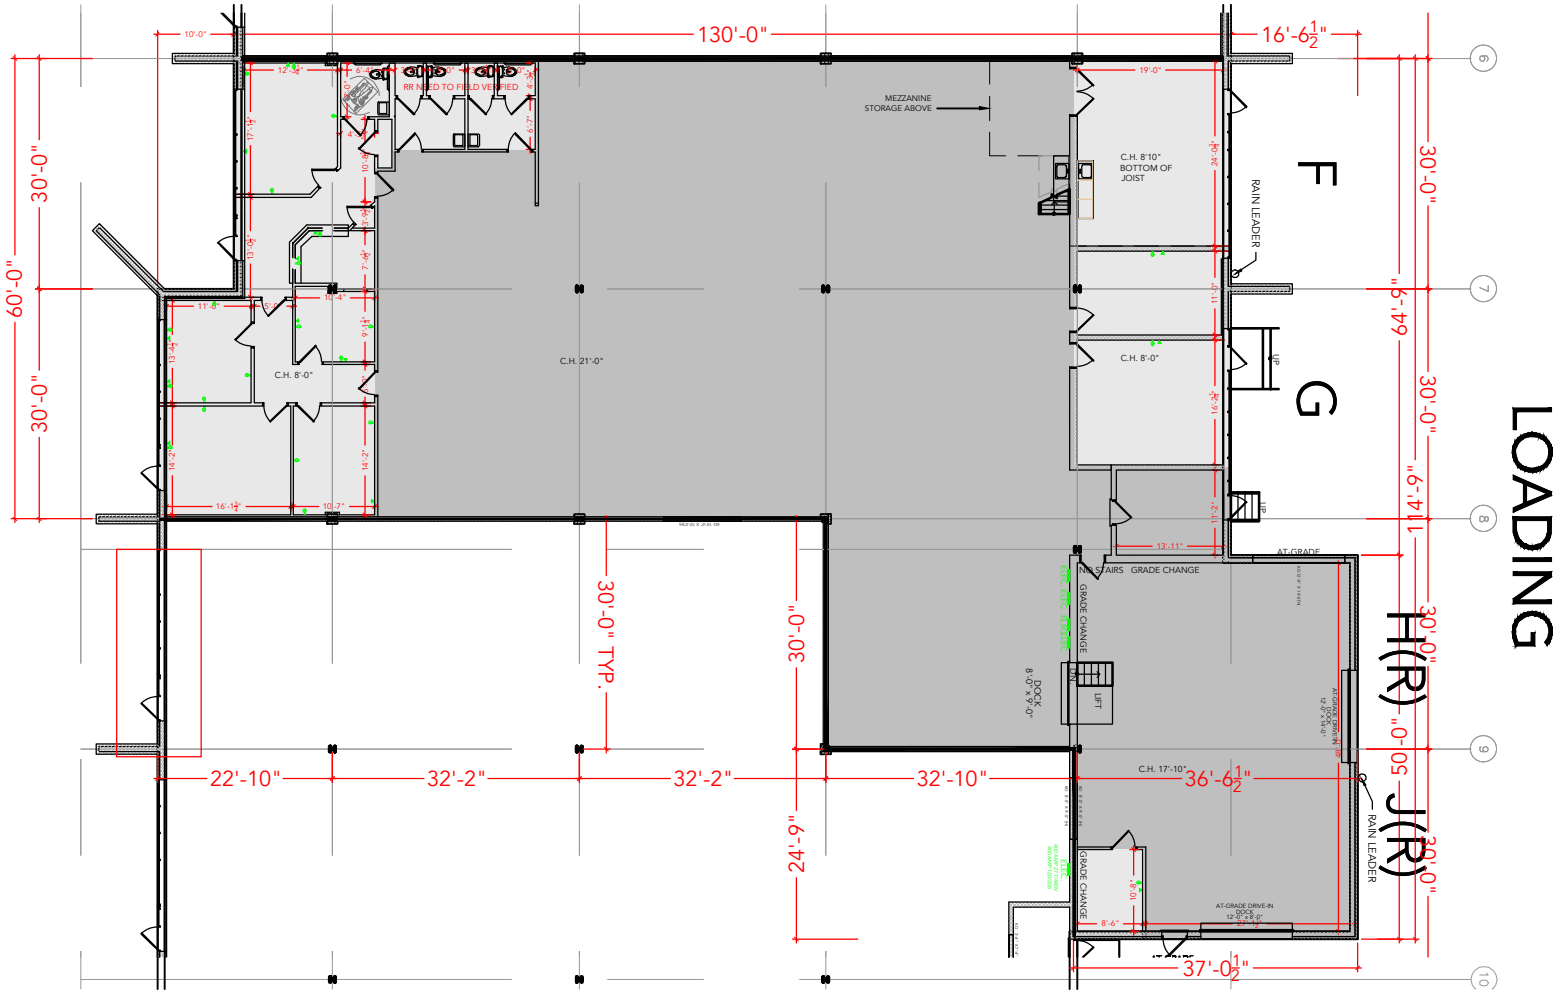


# Floor Plan

PLAN NOT TO SCALE - THIS IS NOT A CONSTRUCTION DOCUMENT

DRAWING #: 072-F-J(R) ASBUILT DATE: **05.24.21**