SETON BUSINESS PARK

4820 SETON DR. BALTIMORE, MD 21215

SUITE F-J(R)

TOTAL SF AVAILABLE -11,055 RSF

OFFICE - 2,877 RSF

WAREHOUSE - 8,178 RSF

* INCLUDES % OF METER ROOM

Click to access **CADD file**

Key Plan

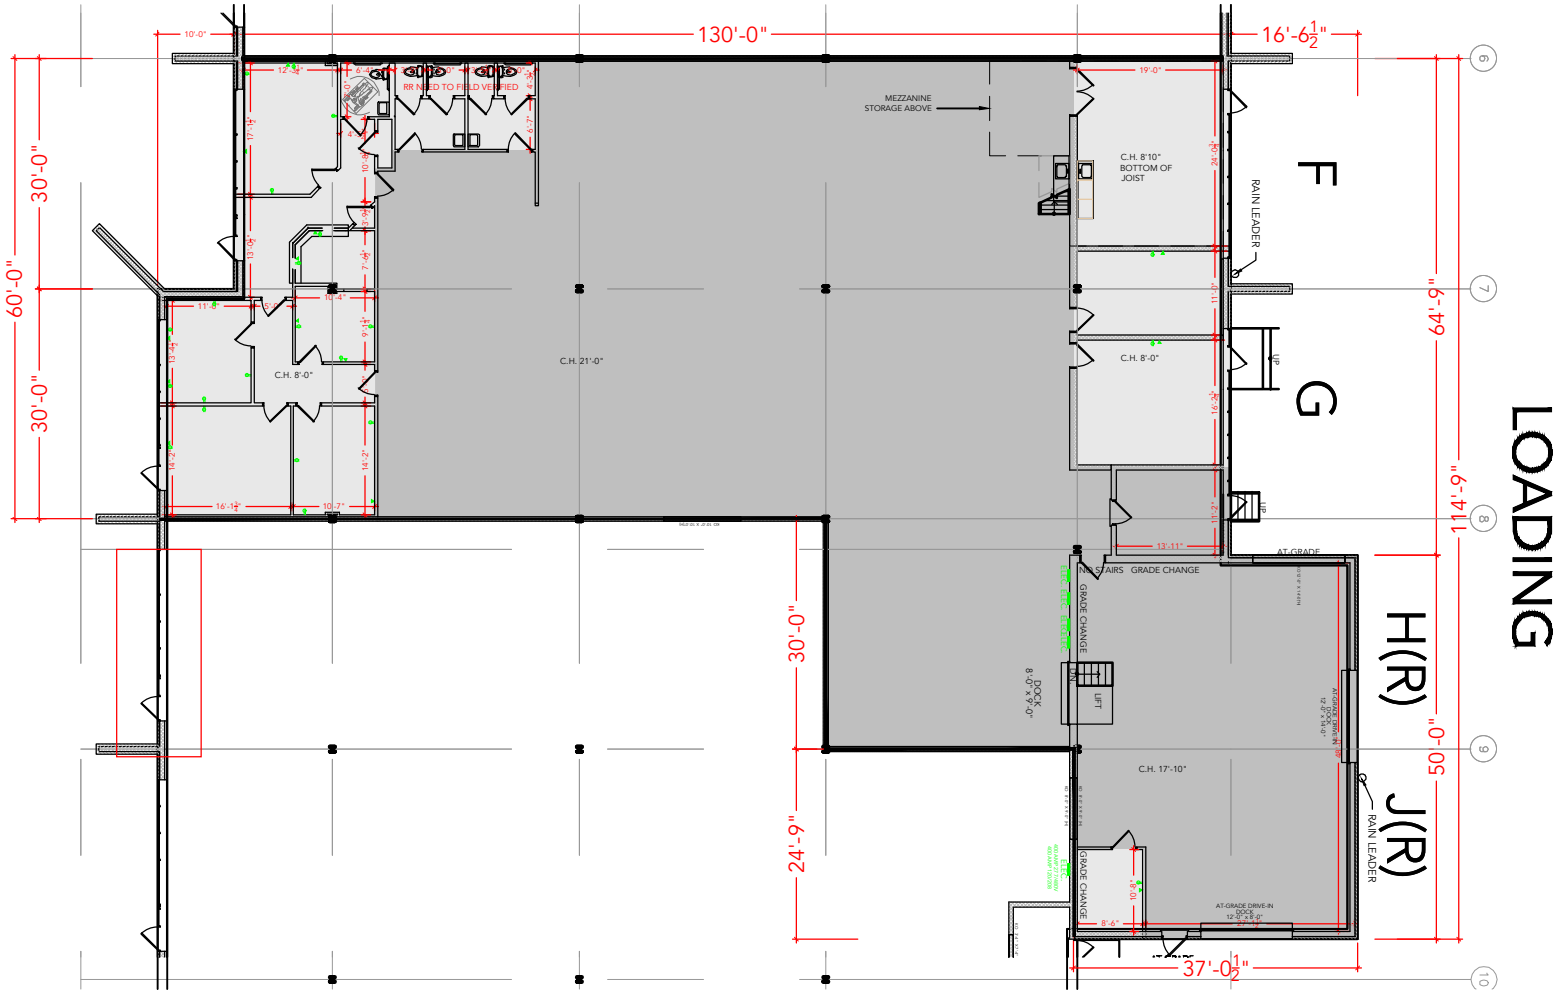

Floor Plan

PLAN NOT TO SCALE - THIS IS NOT A CONSTRUCTION DOCUMENT

DRAWING #: 072-F-J(R) ASBUILT DATE: **05.24.21**