
CURTIS BUSINESS CENTER 1

715 ORDNANCE ROAD BALTIMORE, MD 21226

SUITE 101-103

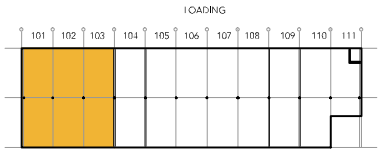


Key Plan

TOTAL SF AVAILABLE -6,000 SF

OFFICE - 2,394 SF

WAREHOUSE - 3,606 SF

Click to access **CADD file**

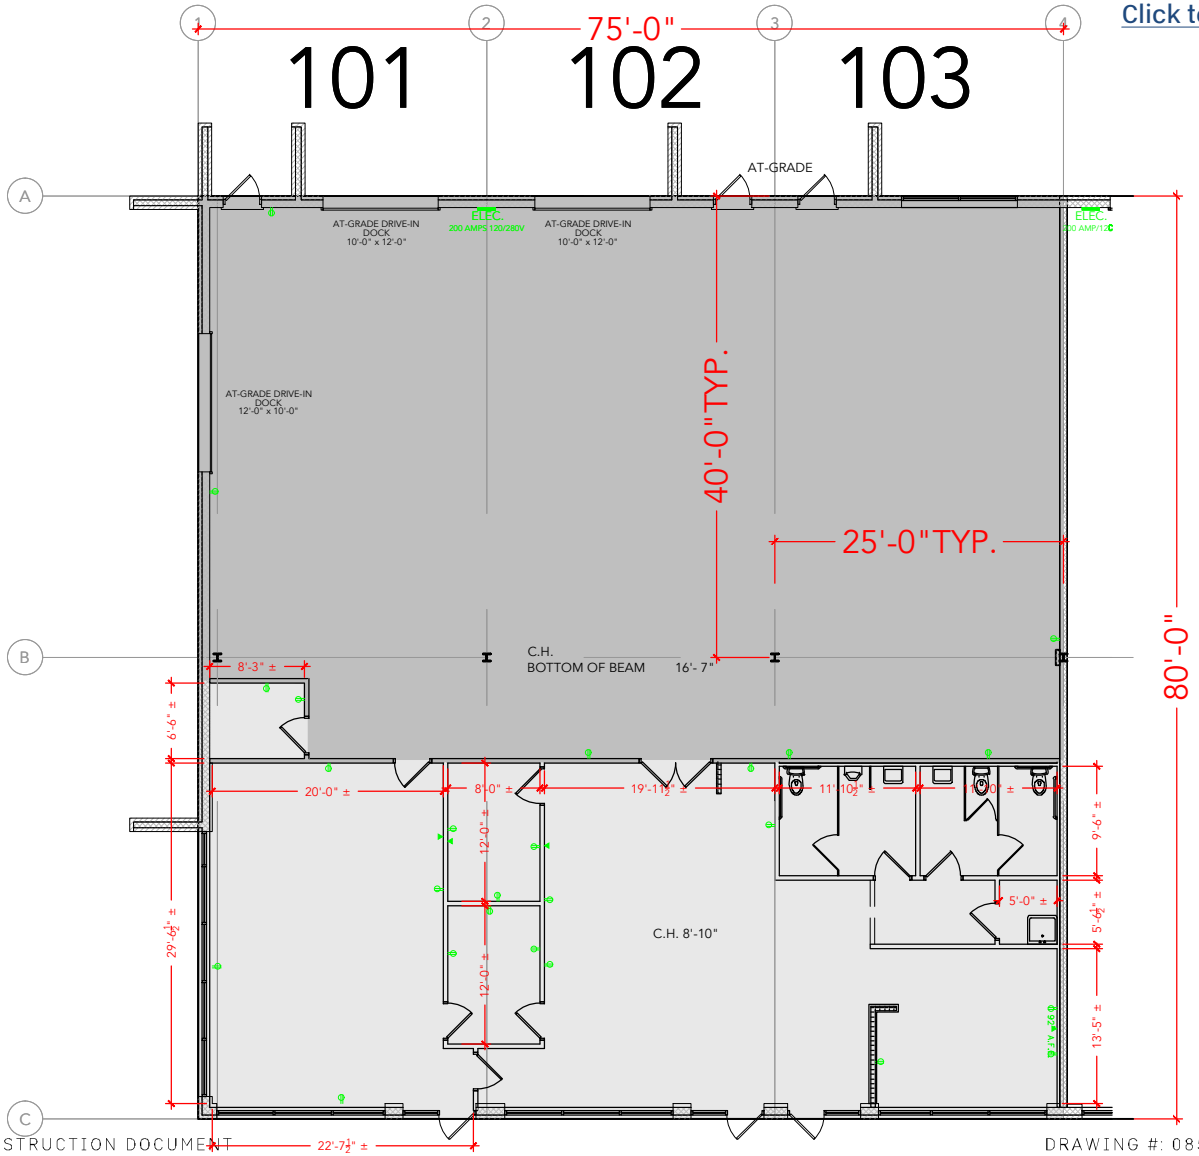

Floor Plan

PLAN NOT TO SCALE - THIS IS NOT A CONSTRUCTION DOCUMENT

DRAWING #: 085-715-101-103 ASBUILT DATE: **09.28.2026**