# OAK HALL LANE

6770 OAK HALL LANE COLUMBIA, MD 21045

SUITE 119

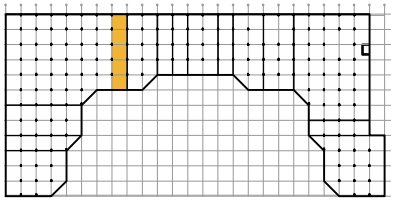

Key Plan

## TOTAL SF AVAILABLE - 3,125 SF

OFFICE - 0,000 SF

WAREHOUSE - 3,125 SF

Click to access **3D** model

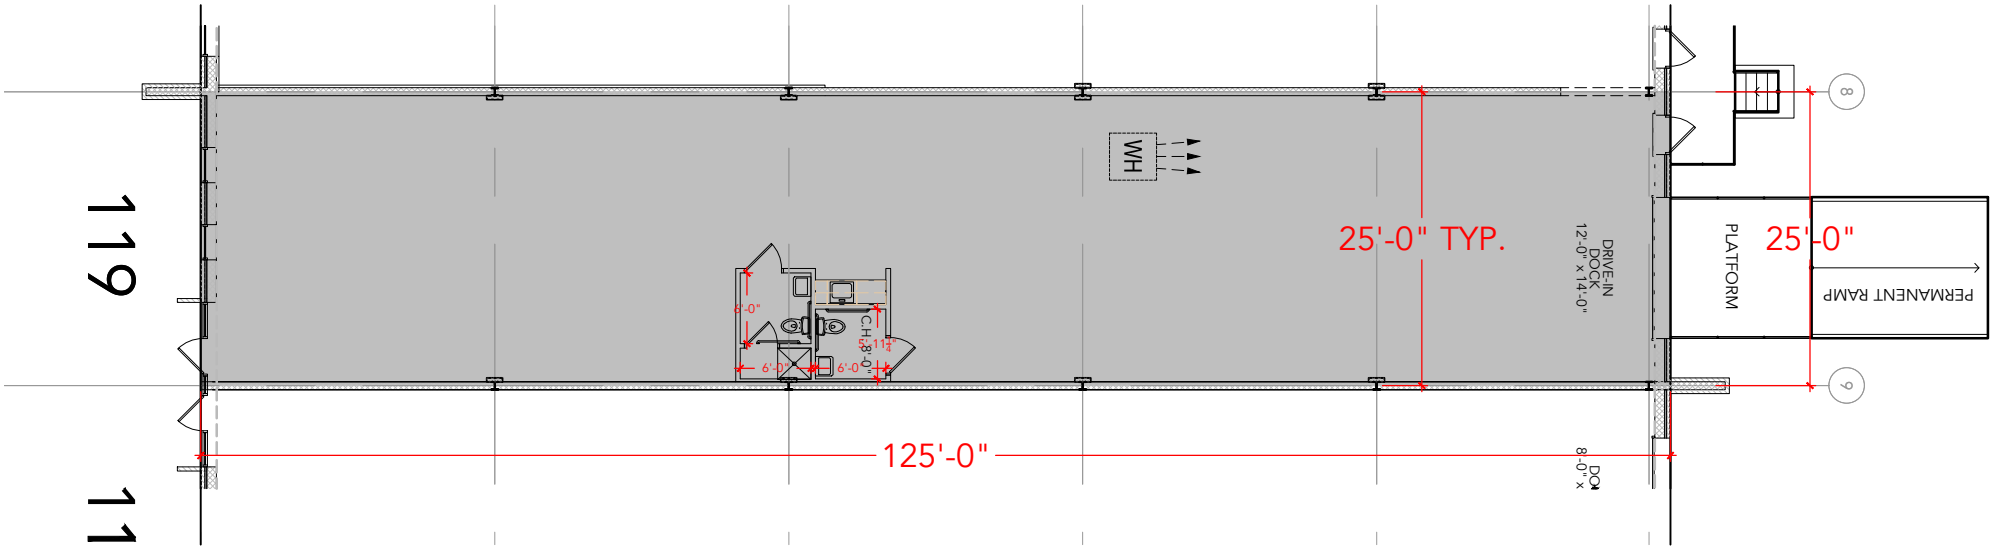


# Floor Plan

PLAN NOT TO SCALE - THIS IS NOT A CONSTRUCTION DOCUMENT

DRAWING #: 087-119 ASBUILT DATE: **04.08.19**