ASHBROOK

20110 ASHBROOK PL ASHBURN, VA 20147

SUITE 155-170-175

TOTAL SF AVAILABLE - 8,897 RSF(12%)

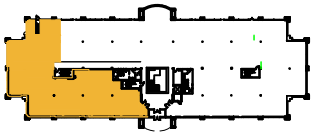

Key Plan

Click to access**3D** model

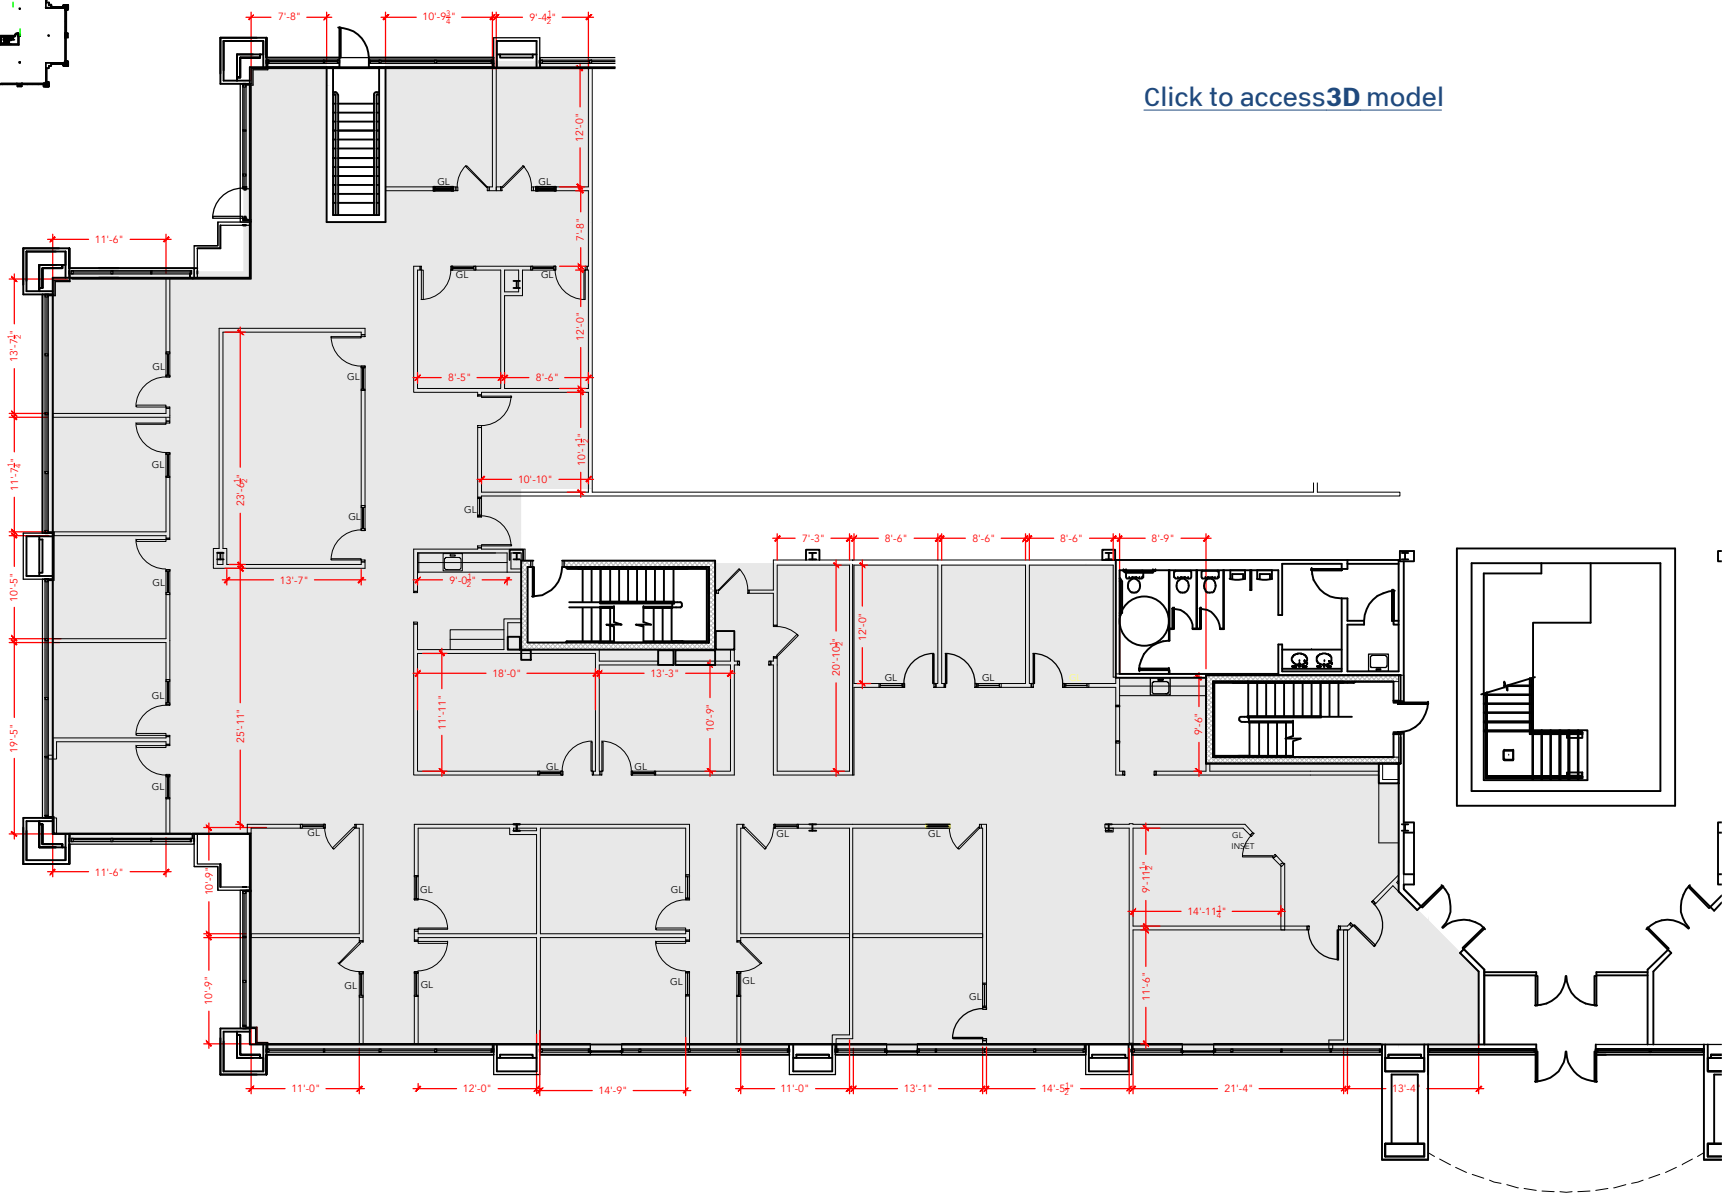

Floor Plan

PLAN NOT TO SCALE - THIS IS NOT A CONSTRUCTION DOCUMENT

DRAWING #: AB5-155-170-175 ASBUILT DATE:**NEEDS TO BE**